

**MISSISSIPPI
BOARD OF WATER COMMISSIONERS**
416 North State Street
Jackson, Mississippi 39201

CODED

WATER WELL DRILLERS LOG

Rankin
T 25
10-66

October 11, 19 66 Layne-Central Company, Rankin
date well completed firm name county well located


LANDOWNER: Pelahatchie
Poultry Company
Pelahatchie, Mississippi
(mailing address)
WELL LOCATION: At Plant
sec. 32 T. 6 N. R 5 E. 1
S. W
_____ miles _____ of _____
(distance) (direction) (nearest town)

WELL PURPOSE: Industrial
(home, irrigation, municipal, industrial)

WELL COMPLETION DATA:
(1) diameter (inches) 10"
(2) total depth (feet) 862'
(3) static water level (feet) _____ below
top of ground. above
(4) casing: 10" 790'
(material) (depth)
_____ if telescope see back.
(size)
(5) screen: 60' 790'
(length) (depth to top)
6" Stainless Steel
(size) (material)
(6) pump 60 500
(HP) (yield gpm)
electric
(type power)
(7) electric log NO
(yes or no)

(organization running log)
(8) how well bottom plugged _____

description of formations encountered	from	to
Clay	0	10
Fine White Sand	10	18
Blue Clay	18	178
White Clay, Soft	178	231
Hard & Soft streaks of		
Lime	231	245
Hard Shale	245	266
Sandy Shale	266	304
Hard Shale	304	354
Fine Sand & Shale Stks.	354	411
Sand, Fine	411	443
Shale & Stks. of Sand	443	461
Brown Shale	461	538
Fine Sand	538	568
Shale & Sand Streaks	568	590
Hard Shale	590	674
Rock	674	675
Hard Shale	675	685
Rock	685	687
Hard Shale	687	697
Rock	697	700
Hard Shale	700	705
Rock	705	707
Shale	707	747
Fine Sand & Shale Stks.	747	780
Hard Packed Sand	780	860
Hard Clay	860	862

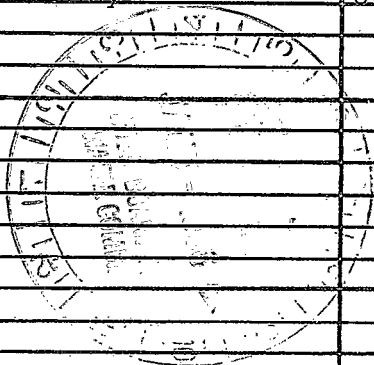

DRILLERS REMARKS:

