

RANKIN MISSISSIPPI BOARD OF WATER COMMISSIONERS

J 26
1-10-63

WATER WELL DRILLERS LOG

CODED

Date: 1/10, 1963, Driller: Frank Dilling County: Statt
(Name)

(1) Owner of Land: J. L. Davis
(Name)
Bellevue, Miss
(Address)

(2) Location: 1/4, 1/4, Sec. 32 T. 6 R. 5
2 miles East of Bellevue
(distance) (direction) (Nearest Town)

(3) Topography: H (Hilly) 1 (Flat) 1 (Level)

(4) Purpose of Well: Chicken house
(Domestic Irrigation, Municipal, Industrial, Other)

Description & Color of Materials Sand, Clay, Red Clay, Shell, etc.	Thick- ness Feet	Depth Feet
Brown clay	0	27
Blue clay		232
shaley		320
lime rock		322
soft shale		382
shale & mdy sand		448
shale		474
fine sand		485
shale		495
fine sand		498
mdy. sand		518
fine sand		528
mdy. sand		538
fine sand		548
mdy. sand		564
fine sand & sh. clay		588
fine sand		616

Information upon completion of well:

(1) Diameter 2 inches.

(2) Total Depth 616 feet.


(3) Water Level _____ feet below top of ground.

(4) Cased to 601, Size 2"

(5) Screen: Size 2" 15, Length 15 ft.

(6) Were any formations sealed against pollution?
_____ yes, no.

CODED

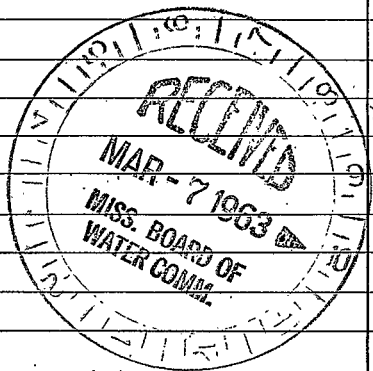

If YES depth of formation _____

Why _____

Drillers Remarks: _____

(Use Back Side)

Well No.

