

RANKIN MISSISSIPPI BOARD OF WATER COMMISSIONERS

J 28

4-11-66

WATER WELL DRILLERS LOG

CODED

Date: 4/11, 1966, Driller: Frost Drilling County Rankin
 (Name)


(1) Owner of Land: E. N. Ross, Jr.
 (Name)
Delatchie, Miss
 (Address)
 (2) Location: 1/4, 1/4, Sec. 33 T6R5
3 miles East of Delatchie
 (distance) (direction) (Nearest Town)
 (3) Topography: /
 (Hilly) (Flat) (Level)
 (4) Purpose of Well: Chicken farm
 (Domestic Irrigation
 Municipal, Industrial, Other)

Description & Color of Materials Sand, Clay, Red Clay, Shell, etc.	Thick- ness Feet	Depth Feet
Brown Clay		28
Blue Clay		192
Soft Shale		222
Shale		252
Shale + Sths Rock		282
Shale		303
Shale + Sths Rock		313
Shale		317
Gandy Shale		333
Shale		368
Shale + Sths 7. band		378
Shale		393
Soft Shale + Milky Sand		423
Shale		443
Shale + Sths 7. band		462
Fine Sand		480
Fine Sand + Sths Clay		493
Fine Sand		503
F Sand + Sths Clay		543
F Sand + Clay		553
Fine Sand		573

Information upon completion of well:

(1) Diameter 2 inches.
 (2) Total Depth 573 feet.
 (3) Water Level 150 feet below top of ground.
 (4) Cased to 558, Size 2"
 (5) Screen: Size 2", Length 15ft.
 (6) Were any formations sealed against pollution?
yes, no.

CODED

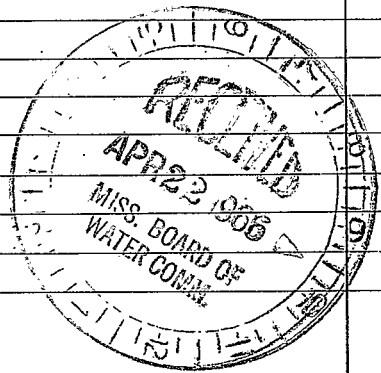

If YES depth of formation _____
 Why _____

Drillers Remarks: _____

(Use Back Side)

Well No.

