

CODED

Rankin
J 33
10-9-68

MISSISSIPPI
BOARD OF WATER COMMISSIONERS
416 North State Street
Jackson, Mississippi 39201

WATER WELL DRILLERS LOG

10/19 1968 Convent Drilling Service Rankin
date well completed firm name county well located

LANDOWNER: Randall King
R#1 Palmetto
Miss
(mailing address)

description of formations encountered	from	to
Red Clay	0	50
Clay Very Crumbly	7	22
Clay Sand		
Dark Clay	22	160
Sand + Clay	160	240
Dark Green Clay	240	390
Clay + Shell	390	470
Fine Sand	470	600
Coarse Sand	600	674

WELL LOCATION:
sec 19 T 6 N R 5 E
S W
5 miles N of Palmetto
(distance) (direction) (nearest town)

WELL PURPOSE: Home
(home, irrigation, municipal, industrial)

- WELL COMPLETION DATA:
- (1) diameter (inches) 2"
 - (2) total depth (feet) 674
 - (3) static water level (feet) 160 below above top of ground.
 - (4) casing Steel 504
(material) (depth)
 if telescope see back.
(size)
 - (5) screen 10 504
(length) (depth to top)
2" S/S
(size) (material)
 - (6) pump Compressor 1/2 H.P.
(HP) (yield gpm)

(type power)
 - (7) electric log X
(yes or no)

(organization running log)
 - (8) how well bottom plugged B Wash

CODED


FEB 10 1969

MISS. BD. OF
WATER COMM.

DRILLERS REMARKS:

If well telescopes please sketch and show depths.

GROUND LEVEL

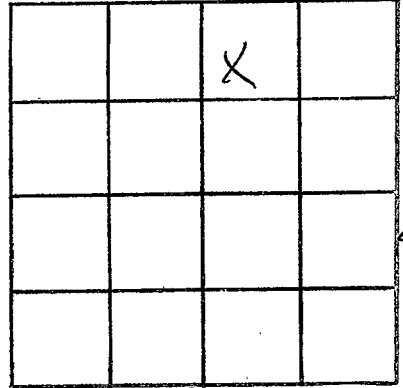

SECTION 19

Please indicate well location X.

ADDITIONAL INFORMATION

A series of horizontal lines for writing additional information.

If more than one screen, show locations of each on sketch.