

MISSISSIPPI
BOARD OF WATER COMMISSIONERS
416 North State Street
Jackson, Mississippi 39201

CODED

WATER WELL DRILLERS LOG

RANKIN
534
11-18-70

11/18 1970 Forest Drilling Rankin
date well completed firm name county well located

LANDOWNER:

Mrs. Mitchell Thomas
118 North Farish Street
Jackson, Miss.
(mailing address)

description of formations encountered

from

to

Brown clay	0	29
Blue clay	29	184
Clay + lime	184	204
Shale + linerock	204	260
Sandy shale	260	280
Shale + strk fine sand	280	347
Clay + fine sand	347	481
Fine sand	481	506
Clay	506	511
Fine sand + strk clay	511	567

WELL LOCATION:

sec 29 T 6 N R 5 E
3 miles NW of Palmdale
(distance) (direction) (nearest town)

WELL PURPOSE: none
(home, irrigation, municipal, industrial)

WELL COMPLETION DATA:

- diameter (inches) 2"
- total depth (feet) 567'
- static water level (feet) 120' below top of ground.
- casing steel, 497'
(material) (depth)
2" if telescope see back.
(size)
- screen 10', 497'
(length) (depth to top)
2", stainless steel
(size) (material)
- pump 3, 15
(HP) (yield gpm)
Collet
(type power)
- electric log yes
(yes or no)
U. S. Geological
(organization running log)
- how well bottom plugged 2"
Backwash Valve

DRILLERS REMARKS:

CODED


DEC 17 1970

MISS. BD. OF
WATER COMM.

FOREST DRILLING SERVICE
231 Highway 25 North
FOREST, MISSISSIPPI

If well telescopes please
sketch and show depths.

GROUND LEVEL

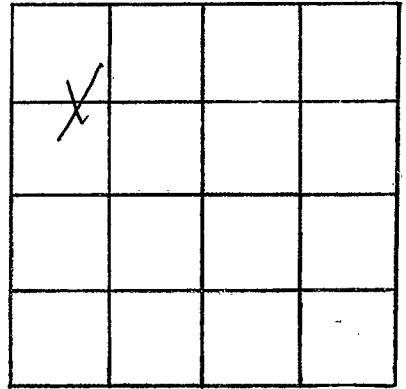

SECTION 29

Please indicate well location X.

ADDITIONAL INFORMATION

If more than one screen,
show locations of each on sketch.