

RANKIN MISSISSIPPI BOARD OF WATER COMMISSIONERS

J36

5-19-66

WATER WELL DRILLERS LOG

CODED

Date: 5/19, 1966, Driller: Forest Drilling Co. Rankin
 (Name)

(1) Owner of Land: Davis Brothers
 (Name)

Belahatchie, Miss
 (Address)

(2) Location: 1/4, 1/4, Sec. 16 T6 R5,
6 miles North of Belahatchie
 (distance) (direction) (Nearest Town)

(3) Topography: Level
 (Hilly) (Flag) (Level)

(4) Purpose of Well: Chicken Farm
 (Domestic Irrigation
 Municipal, Industrial, Other)

Description & Color of Materials Sand, Clay, Red Clay, Shell, etc.	Thick- ness Feet	Depth Feet
Brown Clay		30
Blue Clay		112
Clay + Sths Rock		232
Shale		287
Sandy Shell		295
Rock		297
Sandy Shell		316
Crudgy Sand		376
7 Sand + Sths Clay		336
Shale + Sths 7. Sand		346
Shale		386
Shale + Sths 7. Sand		396
Soft Shale + 7. Sand		426
Shale + Sths Rock		436
Shale + Sths 7. Sand		556
Fin Sand		570
Shale		573
Sand		576
Fair Sand		603

Information upon completion of well:

(1) Diameter 2 inches.

(2) Total Depth 603 feet.

(3) Water Level 181 feet below top of ground.

(4) Cased to 588, Size 2"


(5) Screen: Size 2", Length 15ft.

(6) Were any formations sealed against pollution?
 _____ yes, no.

If YES depth of formation _____
 Why _____

Drillers Remarks: _____

CODED

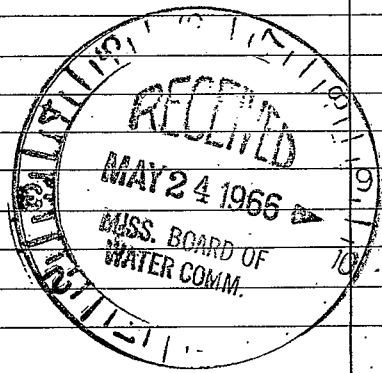

(Use Back Side)

Well No.

