

RANKIN

J 37
7-9-60

WATER WELL DRILLERS LOG

CODED

Rankin

Date: 7/9, 1960, Driller: James McGee County: Scott

(Name)

(1) Owner of Land: Lewis Madison

(Name)

Rt. 1, Morton, Miss.

(Address)

36 6 5

(2) Location: 1/4, 1/4, Sec. T R

7 miles West of Morton

(distance)

(direction)

(Nearest Town)

(3) Topography: X

(Hilly)

(Flat)

(Level)

(4) Purpose of Well: Domestic

(Domestic Irrigation
Municipal, Industrial, Other)

Information upon completion of well:

(1) Diameter 2 inches.

(2) Total Depth 385 feet.

(3) Water Level 160 feet below top of ground.

(4) Cased to 370', Size 2"

(5) Screen: Size 2", Length 15'

(6) Were any formations sealed against pollution?

no yes, X no.


If YES depth of formation _____

Why _____

Drillers Remarks: Good well.

Description & Color of Materials Sand, Clay, Red Clay, Shell, etc.	Thick- ness Feet	Depth Feet
Brown Clay.	0	28
Blue Clay	28	102
Clay & Lime Rock.	102	142
Clay.	142	160
Clay & Stks. Lime Rock.	160	172
Clay & Shell.	172	182
Clay.	182	192
Clay & Stks. Sand.	192	202
Mucky Clay.	202	212
Clay & Stks. Sand.	212	222
Clay & Mucky Sand.	222	257
Clay.	257	265
Muck.	265	272
Mucky Sand.	272	282
Clay.	282	294
Fine Sand.	294	302
Clay.	302	310
Fine Sand.	310	322
Fine Sand & Stks. Clay	322	348
Fine Sand. (Screen Set)	348	365

CODED

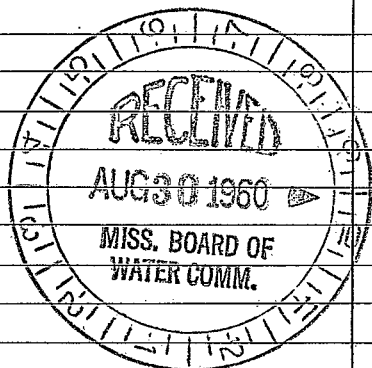

(Use Back Side)

Well No.

1950

1951

1952

1953

1954

1955

1956

1957