

RANKIN  
J38  
8-10-60

WATER WELL DRILLERS LOG

CODED

Date: 8/10, 1960, Driller: James McGee County: Scott  
(Name)

(1) Owner of Land: Miss. Nan Jones.  
(Name)  
Morton, Miss.  
(Address)

(2) Location: 1/4, 1/4, Sec. 2565 T. R.  
7 miles West of Morton  
(distance) (direction) (Nearest Town)

(3) Topography: X  
(Hilly) (Flat) (Level)

(4) Purpose of Well: Domestic.  
(Domestic Irrigation  
Municipal, Industrial, Other)

Description & Color of Materials Sand, Clay, Red Clay, Shell, etc.	Thick- ness Feet	Depth Feet
Brown Clay.	0	28
Blue Clay.	28	40
Brown Clay.	40	50
Blue Clay.	50	152
Gumbe.	152	203
Lime Rock.	203	205
Clay.	205	216
Lime Rock.	216	218
Hard Clay & Lime Rock.	218	242
Hard Clay.	242	278
Lime Rock & Shell.	278	282
Sandy Shell.	282	302
Shale.	302	330
Clay & Stks. Fine Sand.	330	376
Clay	376	440
Shale.	440	490
Shale & Stks. Sand.	490	510
Fine Sand.	510	540
Sand. (Screen Set.)	540	560
Clay.	560	562

Information upon completion of well:

(1) Diameter 2 inches.

(2) Total Depth 560 feet.

(3) Water Level 145 feet below top of ground.

(4) Cased to 550', Size 2"


(5) Screen: Size 2", Length 10'

(6) Were any formations sealed against pollution?  
yes, X no.

If YES depth of formation \_\_\_\_\_

Why \_\_\_\_\_

Drillers Remarks: Good Well.

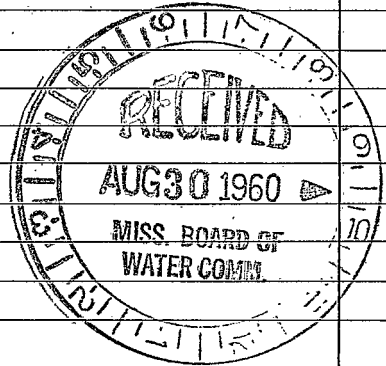

(Use Back Side)

Well No.

