

RANKIN
J 39
8-26-71

MISSISSIPPI
 BOARD OF WATER COMMISSIONERS
 416 North State Street
 Jackson, Mississippi 39201

CODED

WATER WELL DRILLERS LOG

8-28 1971 Forest Drilling Inc. Rankin
 date well completed firm name county well located.

LANDOWNER:	description of formations encountered	from	to
Bulba Flannigan	Brown clay	0	10
Pelahatchie, Miss.	Chalky clay	10	28
	Blue clay	28	266
(mailing address)	Hard shale + stks. Rock	266	327
WELL LOCATION:	Soft clay + silt	327	455
sec. 21 T. 6 N R. 5 E	Hard shale	455	553
3 miles N Pelahatchie	Soft clay + silt	553	567
(distance) (direction) (nearest town)	Shale + silt	567	594
WELL PURPOSE: Road drainage	Shale + stks. silt	594	610
(home, irrigation, municipal, industrial)	Fine sand	610	625
WELL COMPLETION DATA:			
(1) diameter (inches) 2"			
(2) total depth (feet) 620'			
(3) static water level (feet) 190 below top of ground.			
(4) casing Galv. 610' (material) (depth)			
2" (size) if telescope see back.			
(5) screen 10' 610' (length) (depth to top)			
2" (size) Stainless Steel (material)			
(6) pump 5 (HP) 20 gal (yield gpm)			
Electric (type power)			
(7) electric log No (yes or no)			
(organization running log)			
(8) how well bottom plugged 2" Backwash Valve			
DRILLERS REMARKS:			


CODED

OCT 22 1971

MISS. Bd. of WATER COMMISSIONERS

If well telescopes please sketch and show depths.

GROUND LEVEL

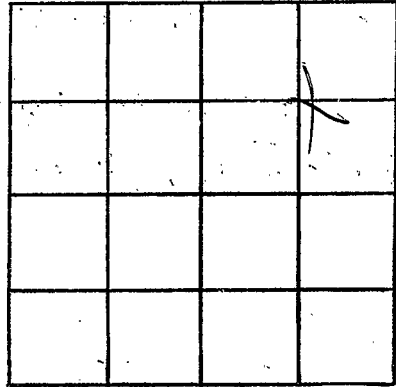

SECTION 21

Please indicate well location X.

ADDITIONAL INFORMATION

If more than one screen, show locations of each on sketch.