

**RANKIN**  
**J40**  
**7-26-72**

MISSISSIPPI  
 BOARD OF WATER COMMISSIONERS  
 416 North State Street  
 Jackson, Mississippi 39201

WATER WELL DRILLERS LOG

**CODED**

7/26 1972 Frank Drilling Rankin  
 date well completed firm name county well located

LANDOWNER:  
James McNeil  
Rt 2 box 18 - Relatachie  
 (mailing address)

WELL LOCATION:  
 sec. 35 T. 6 N. R. 5 E.  
2 miles East of Relatachie  
 (distance) (direction) (nearest town)

WELL PURPOSE: Home  
 (home, irrigation, municipal, industrial)

WELL COMPLETION DATA:  
 (1) diameter (inches) 2"  
 (2) total depth (feet) 532  
 (3) static water level (feet) 166 below above top of ground.  
 (4) casing 2" 532  
 (material) (depth)  
2" if telescope see back.  
 (size)  
 (5) screen 15 517  
 (length) (depth to top)  
2" Brass  
 (size) (material)  
 (6) pump 3 HP 1000 gpm  
 (HP) (yield gpm)  
Elch  
 (type power)  
 (7) electric log No  
 (yes or no)  
 (organization running log)  
 (8) how well bottom plugged Brass  
True

description of formations encountered	from	to
<u>Clay</u>	<u>0</u>	<u>4</u>
<u>Sand</u>		<u>110</u>
<u>Clay</u>		<u>20</u>
<u>Blue Clay</u>		<u>265</u>
<u>Clay &amp; the Rock</u>		<u>327</u>
<u>Shale</u>		<u>408</u>
<u>Exp. &amp; Strat Sand</u>		<u>430</u>
<u>Shale</u>		<u>460</u>
<u>Exp. Sand</u>		<u>471</u>
<u>Shale</u>		<u>498</u>
<u>Exp. Sand</u>		<u>491</u>
<u>Fin Sand</u>		<u>532</u>

**CODED**


AUG - 3 1972

MISS. Bd. of  
 WATER COMM

DRILLERS REMARKS:

If well telescopes please sketch and show depths.

GROUND LEVEL

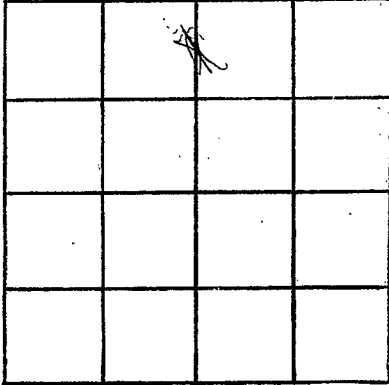

SECTION 38

Please indicate well location X.

ADDITIONAL INFORMATION

Horizontal lines for additional information.

If more than one screen, show locations of each on sketch.