

RANKIN
 J45
 10-26-78
 Lot # 473

MISSISSIPPI
 BOARD OF WATER COMMISSIONERS
 416 North State Street
 Jackson, Mississippi 39201

WATER WELL DRILLERS LOG

10-26-78 19 Gunn Waterwell Service Rankin
 date well completed firm name county well located

LANDOWNER:
A.R. JOHNSON
 (mailing address)


WELL LOCATION:
 sec. 29 T. 6 N. R. 5 E
 (distance) miles (direction) of (nearest town)

WELL PURPOSE:
 (home, irrigation, municipal, industrial)

WELL COMPLETION DATA:
 (1) diameter (inches) 2"
 (2) total depth (feet) 489
 (3) static water level (feet) 100 below above top of ground.
 (4) casing PVC 489
 (material) (depth)
2 if telescope see back.
 (size)
 (5) screen 20 489
 (length) (depth to top)
2 PVC
 (size) (material)
 (6) pump 3 25
 (HP) (yield gpm)
 (type power)
 (7) electric log (yes or no)
M 45
 (organization running log)
 (8) how well bottom plugged BNK

description of formations encountered	from	to
CLAY	0	370
Sand	370	330
CLAY	330	280
SANDY CLAY	380	400
CLAY	400	480
Sand	480	489


DRILLERS REMARKS:

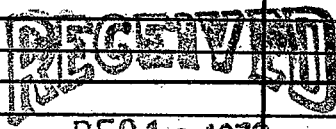

DEC 13 1978

If well telescopes please sketch and show depths.

GROUND LEVEL

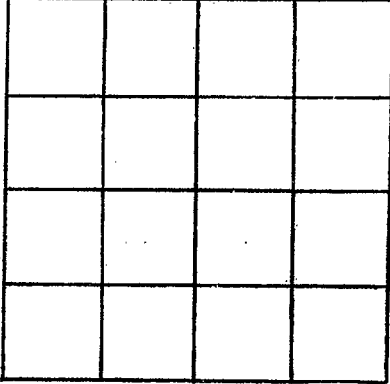

SECTION _____

Please indicate well location X.

ADDITIONAL INFORMATION

A series of horizontal lines forming a table for recording additional information, starting below the 'ADDITIONAL INFORMATION' header and extending down to the bottom of the page.

If more than one screen, show locations of each on sketch.