

RANKIN  
J 2000  
10-13-78

MISSISSIPPI  
 BOARD OF WATER COMMISSIONERS  
 416 North State Street  
 Jackson, Mississippi 39201

WATER WELL DRILLERS LOG

10-13 1978 Comens Drilling Service Rankin  
 date well completed firm name county well located

LANDOWNER: Catherine Board

West side of Pelahatchie Lake  
Jackson ms  
 (mailing address)

WELL LOCATION:

sec. 20 T. 10 N. R. 5 E  
 S W  
2 miles N of Pelahatchie  
 (distance) (direction) (nearest town)

WELL PURPOSE:

Home  
 (home, irrigation, municipal, industrial)

WELL COMPLETION DATA:

- (1) diameter (inches) 2"
- (2) total depth (feet) 540
- (3) static water level (feet) 85 below top of ground.
- (4) casing metal, 530  
 (material) (depth)  
 (size) If telescope see back.
- (5) screen 10ft, 530  
 (length) (depth to top)  
2" Stainless Steel  
 (size) (material)
- (6) pump 2 6  
 (HP) (yield gpm)  
Electric  
 (type power)
- (7) electric log no  
 (yes or no)

(organization running log)

(8) how well bottom plugged Bad

description of formations encountered	from	to
<u>Crumbly Clay</u>	<u>0</u>	<u>15</u>
<u>Fine Clay</u>	<u>15</u>	<u>250</u>
<u>Sand &amp; Shell fragments</u>	<u>250</u>	<u>285</u>
<u>Pelahatchie Clay</u>	<u>285</u>	<u>350</u>
<u>Fine sand</u>	<u>350</u>	<u>365</u>
<u>Clay</u>	<u>365</u>	<u>403</u>
<u>Clay &amp; sand</u>	<u>403</u>	<u>530</u>
<u>Good sand</u>	<u>530</u>	<u>540</u>

Miss. Board of Water Comm.


JUL 18 1979

DRILLERS REMARKS:

RECEIVED

If well telescopes please sketch and show depths.

GROUND LEVEL

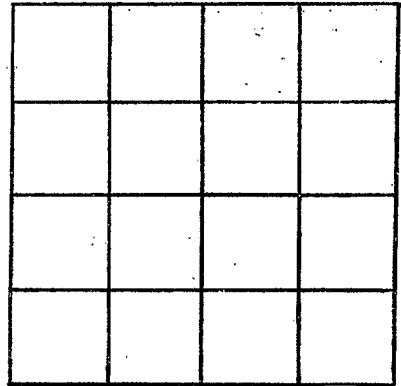

SECTION \_\_\_\_\_

Please indicate well location X.

ADDITIONAL INFORMATION

If more than one screen,  
show locations of each on sketch.