

MISSISSIPPI DEPARTMENT OF NATURAL RESOURCES

Bureau of Land and Water Resources

Southport Mall

P.O. Box 10631

Jackson, Mississippi 39209

WATER WELL DRILLERS LOG

RANKIN
J
2001

May 9, 1976 date well completed

THOMAS DRILLING & SUPPLY CO. firm name

Rankin county well located

LANDOWNER: John Little

Highway 43 North

Pelahatchie, MS

(mailing address)

description of formations encountered	from	to
Yellow Chalk	0	30
Blue "	30	220
Yellow + Brown Chalk	220	280
Fine Gray Sand	280	310
Mixed Chalk	310	400
Fine Gray Sand	400	515

WELL LOCATION:

sec. 29 T. 86 N. R. 5 E

1 miles N of Pelahatchie

(distance) (direction) (nearest town)

WELL PURPOSE: Home

(home, irrigation, municipal, industrial)

WELL COMPLETION DATA:

(1) diameter (inches) 2"

(2) total depth (feet) 515'

(3) static water level (feet) 150' <sup>below</sup> above top of ground.

(4) casing PVC ~~4~~ 515' (material) (depth)

2" if telescope see back. (size)

(5) screen 30' 585' (length) (depth to top)

2' PVC (size) (material)


(6) pump 20 (HP) 10 (yield gpm)

Elec (type power)

(7) electric log (yes or no)

(organization running log)

(8) how well bottom plugged Cap

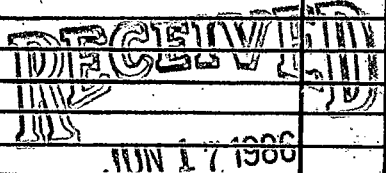

Department of Natural Resources  
Bureau of Land & Water Resources

DRILLERS REMARKS:

If well telescopes please  
sketch and show depths.

GROUND LEVEL

	X		

SECTION 29

Please indicate well location X.

ADDITIONAL INFORMATION

If more than one screen,  
show locations of each on sketch.