

MISSISSIPPI DEPARTMENT OF NATURAL RESOURCES

Bureau of Land and Water Resources

COUNTY WELL LOCATED Rankin	
WELL NUMBER 298819	CODED
J 2007	
DATE WELL COMPLETED 8-02-95	

PERMIT NUMBER 510
NAME OF DRILLING FIRM Easley Water Wells
Brookhaven, MS 39601

P.O. Box 10631
Jackson, Mississippi 39209
WATER WELL DRILLERS LOG

NAME & MAILING ADDRESS OF LANDOWNER Charles Tripplett		
WELL LOCATION: SEC	TOWNSHIP	RANGE
30	6N	5E
<div style="display: flex; justify-content: space-around;"> N S E W </div>		
DISTANCE	DIRECTION	NEAREST TOWN
_____ Miles	_____ of _____	_____
OTHER LANDMARK		
WELL PURPOSE: Home, Irrigation, Municipal, Industrial, Fish Pond, etc.		

PUMP DATA		
PUMP TYPE (Circle One): Submersible , Turbine, Jet, Flowing Well, Other (Describe) _____		
POWER TYPE (Circle One): Electric , Tractor, Diesel, Gasoline, Butane, Other (Describe) _____		
Pump Capacity (GPM)	No. of Stages	Setting Depth
_____	_____	_____ FT.
PUMP TEST		
Well yielded _____ GPM with		
a drawdown of _____ ft.		
after _____ hours of pumping		

WELL DATA		
Well Depth 547'	Casing Diameter (In.) 4"	Casing Length (Ft.) 527
Type of Casing PVC	Hole Depth 561	Depth to Static Water Level
TYPE OF COMPLETION: (Circle One or More): Natural Development , Underreamed, Telescoped, Gravel Packed, Open Hole, Other		
Top of Lap Pipe or Reduction in Casing		
FEET <input type="checkbox"/> IF TELESCOPED OR MORE THAN ONE SCREEN: USE BACK PAGE		

LOG DATA	
TYPE OF LOG RUN (Circle One): No Log Run, Electric, Gamma Ray, Density, Sonic, Neutron, Other (Describe) _____	
Name of Organization Running Log	

SCREEN DATA		
Diameter - Inches 4"	Length - Feet 20	Slot Size - Inches 8
Screen Type PVC	Depth to Bottom - Feet 547	

GEOLOGIC DATA (Office Use Only)			
Surface Elev.	Geologic Unit	Unit Thickness	Depth to Top
Subs. SWL	Date	Analysis	Aquifer Test

Driller's Remarks


RECEIVED

DESCRIPTION OF FORMATIONS ENCOUNTERED	FROM	TO	FORMATIONS (Continued)
Clay	0	380	<div style="font-size: 2em; font-weight: bold; opacity: 0.5;">RECEIVED</div> <p style="font-size: 1.2em; font-weight: bold;">AUG 02 1996</p> <p style="font-size: 0.8em; font-weight: bold;">Dept. of Environmental Quality Office of Land & Water Resources</p>
Sand shells	380	410	
CLAY	410	527	
SAND	527	547	
CLAY	547	561	

IF MORE SPACE IS NEEDED, USE BACK

If well telescopes please
sketch and show depths.

GROUND LEVEL

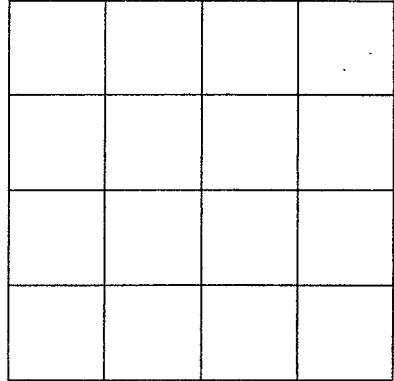

SECTION _____

Please indicate well location X.

ADDITIONAL INFORMATION

If more than one screen,
show location of each on sketch.