

RANKIN MISSISSIPPI BOARD OF WATER COMMISSIONERS

K 76
2-22-62

WATER WELL DRILLERS LOG

CODED

Date: 2-22- 1962 , Driller: Layne-Central Co. County: Rankin

(Name)

Description & Color of Materials Sand, Clay, Red Clay, Shell, etc.	Thick- ness Feet	Depth Feet
red sand fill	3	3
soft clay	15	18
med. sand	7	25
coarse sand & gravel	20	45
clay	95	140
sandy shale	218	358
shale	88	446
rock	2	448
shale	13	461
rock	3	464
shale	37	501
fine sand	24	525
break	3	528
sand	8	536
shale	7	543
sand	34	577
sandy shale	11	588
sand	11	599
broken sand	61	660
sandy shale	15	675
sand	131	806
sandy shale		

(1) Owner of Land: G. M. & O. Land Co.

(Name)

Jackson, Mississippi

(Address)

(2) Location: 1/4, 1/4, Sec. 8 T 5 R

1/4 miles east of Pearl
(distance) (direction) (Nearest Town)

(3) Topography: _____
(Hilly) (Flat) (Level)

(4) Purpose of Well: Industrial
(Domestic Irrigation Municipal, Industrial, Other)

Information upon completion of well:


- (1) Diameter 10 inches.
- (2) Total Depth 763' feet.
- (3) Water Level 134' feet below top of ground.
- (4) Cased to 706' , Size 10"
- (5) Screen: Size 6" , Length 65' 8"
- (6) Were any formations sealed against pollution?

yes, no.

If YES depth of formation 706'

Why required

Drillers Remarks: _____

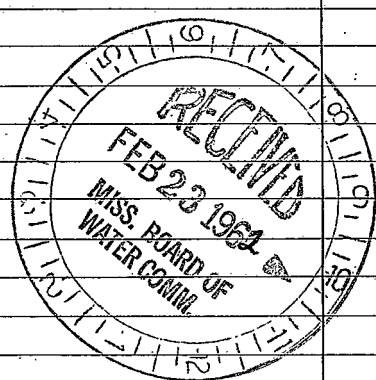

(Use Back Side)

Well No.

⑦