

RANKIN
K 79
10-61

MISSISSIPPI BOARD OF WATER COMMISSIONERS

WATER WELL DRILLERS LOG

CODED 9

Date: Oct, 1961, Driller: MENECE DRILLING Co. County RANKIN
(Name Co.)

(1) Owner of Land: DR G.E. GODMAN
(Name)

251 Georgia Ave Jackson Miss
(Address)

(2) Location: E 1/4 SW 1/4, Sec. 12 T5R2
4 miles W of BRANDON
(distance) (direction) (Nearest Town)

(3) Topography: Hilly
(Hilly) (Flat) (Level)

(4) Purpose of Well: DOMESTIC
(Domestic Irrigation
Municipal, Industrial, Other)

Description & Color of Materials Sand, Clay, Red Clay, Shell, etc.	Thick- ness Feet	Depth Feet
SURFACE Soil	3	0
YELLOW SHALE	37	3
SHALY SAND	27	40
SHALE	42	67
FINE SAND	21	109
SHALE & LIGNITE	20	130
SAND & SHALE	42	150
GREY SHALE	364	192
SHALE, SAND & SHELL	22	556
FINE SAND & LIGNITE	20	578
FINE SAND & SHALE	86	598
FINE SAND	86	684
COARSE SAND	29	770
		809

Information upon completion of well:

(1) Diameter 4"x2" inches.

(2) Total Depth 809 feet.


(3) Water Level 210 feet below top of ground.

(4) Cased to 320, Size 4"
320-809' / 2"

(5) Screen: Size 2, Length 20.

(6) Were any formations sealed against pollution?
yes, no.

CODED

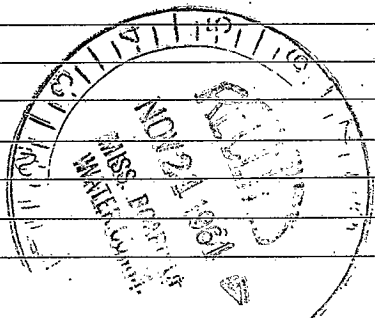

(Use Back Side)

Well No.
23

