

RANKIN
K85

MISSISSIPPI BOARD OF WATER COMMISSIONERS

MGS
K2

5-11-65

WATER WELL DRILLERS LOG

CODED

Date: 5/11, 1965, Driller: Garret Williams County: Scott
(Name)

(1) Owner of Land: J. N. Muse
(Name)

Gold Brandon Rd.
Jackson, Miss.
(Address)

(2) Location: 1/4, 1/4, Sec. 9 T. 5R E. 2
1 1/2 miles East of Jackson
(distance) (direction) (Nearest Town)

(3) Topography: Level
(Hilly) (Flat) (Level)

(4) Purpose of Well: Home
(Domestic Irrigation
Municipal, Industrial, Other)

Description & Color of Materials Sand, Clay, Red Clay, Shell, etc.	Thick- ness Feet	Depth Feet
Brown Clay	0	25
Blue Clay		205
Fine Shell, Shale, Lignite		245
Shale + Soft Clay		348
Shale + Shs silt		368
Fine Sand		420
Shale + Shs silt		427
Fine Sand		430
Shale + Shs Sand		456
Silt, soft clay + lignite		472
Shale		576
Shale + Shs Rock		638
Shale, Lignite + silt		711
Fine Sand + Shs, Shale		721
Shale + Shs silt		742
Shale		763
Shale + Shs silt		842
Fine Sand		883
Med. Sand		897

Information upon completion of well:

(1) Diameter 2 inches.

(2) Total Depth 897 feet.


(3) Water Level 184 feet below top of ground.

(4) Cased to 882, Size 2"

(5) Screen: Size 2", Length 15 ft.

(6) Were any formations sealed against pollution?
 yes, no.

CODED

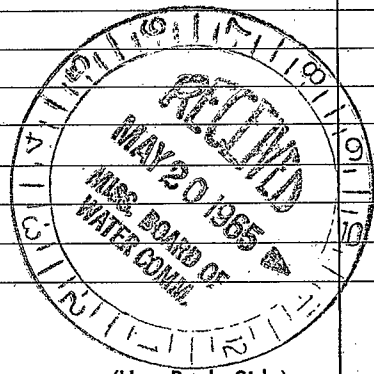

(Use Back Side)

Well No.

