

MG5  
CODED

MISSISSIPPI  
BOARD OF WATER COMMISSIONERS  
416 North State Street  
Jackson, Mississippi 39201

WATER WELL DRILLERS LOG

Rankin  
K 92  
8-67  
Elec 109

8-20 date well completed      1967 Layne Central Co. firm name      RANKIN county well located

LANDOWNER:

Miss. State Hospital  
Whitfield, Miss.  
(mailing address)

description of formations encountered

	from	to
SANDY CLAY	0	20
SAND ROCK	20	29
HARD ROCK	29	30
FINE SAND	30	53
SANDY SHALE	53	120
YELLOW CLAY	120	535
SANDY SHALE	535	692
FINE SAND-STREAKS SHALE	692	775
SAND	775	844
SANDY SHALE	844	885

WELL LOCATION:

SE SE SE  
sec. 27 T. 5 N. R. 2 E  
S W


\_\_\_\_\_ miles of \_\_\_\_\_  
(distance) (direction) (nearest town)

WELL PURPOSE:

Domestic  
(home, irrigation, municipal, industrial)

WELL COMPLETION DATA:

- (1) diameter (inches) 18"
- (2) total depth (feet) 844'
- (3) static water level (feet) 161' below top of ground.
- (4) casing Steel, 778'  
(material) (depth)  
\_\_\_\_\_ if telescope see back.  
(size)
- (5) screen 60', 778'  
(length) (depth to top)  
10", Stainless Steel  
(size) (material)
- (6) pump 125  
(HP) (yield gpm)  
Electric  
(type power)
- (7) electric log YES  
(yes or no)  
U.S.G.S.  
(organization running log)
- (8) how well bottom plugged \_\_\_\_\_

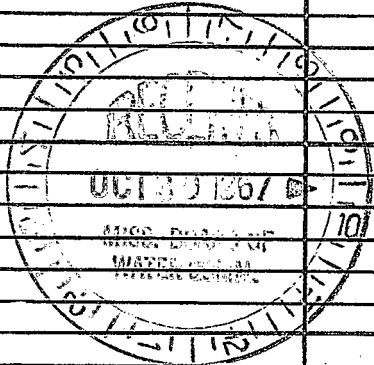

DRILLERS REMARKS:

No test Run AS  
of this date.

