

ELOG #182

M.G.S
K18

CODED

Rankin
K 9.3
11-67
Elec Log
11-14-67

MISSISSIPPI
BOARD OF WATER COMMISSIONERS
416 North State Street
Jackson, Mississippi 39201

WATER WELL DRILLERS LOG

19 Gordon-McNeese Rankin
date well completed firm name county well located

LANDOWNER Johnny Cleveland
Treller Court # 2


Hwy 495 Jackson
(mailing address)

WELL LOCATION:
sec 14 T 5 N R 1 E
1/2 miles South of Jackson
(distance) (direction) (nearest town)

WELL PURPOSE: Treller Court
(home, irrigation, municipal, industrial)

- WELL COMPLETION DATA:
- (1) diameter (inches) 4" x 2 1/2"
 - (2) total depth (feet) 705
 - (3) static water level (feet) 140 below top of ground.
 - (4) casing steel 655
(material) (depth)
4" x 2 1/2" If telescope see back.
(size)
 - (5) screen 40' 655
(length) (depth to top)
2 1/2 stainless steel
(size) (material)
 - (6) pump 3 20
(HP) (yield gpm)
Elcc
(type power)
 - (7) electric log yes
(yes or no)
M.G.S.
(organization running log)
 - (8) how well bottom plugged _____

description of formations encountered	from	to
Clay	0	20
Sand	20	35
Grey shale sdy	35	360
Rock	360	363
Grey sly sh Rock strk	363	524
SEND	524	524
SDY SH	524	545
SEND	545	586
SEND - sh strk	586	626
SEND	626	705

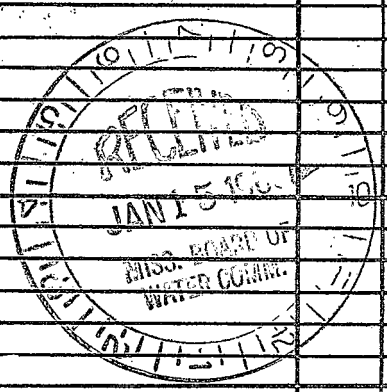

DRILLERS REMARKS:
water clear

If well telescopes please sketch and show depths.

GROUND LEVEL

4' 294' 6"
4" x 2 1/2" screen 1
275' 6"

2 1/2" Pipe 379' 6"
655' 0"

2 1/2" screen 40
695' 0"

2 1/2" Pipe 10
705'

SECTION 14

Please indicate well location X.

ADDITIONAL INFORMATION

If more than one screen, show locations of each on sketch.