

Rankin
K 94
2-68

MISSISSIPPI
BOARD OF WATER COMMISSIONERS
416 North State Street
Jackson, Mississippi 39201

MGS
522

CODED

WATER WELL DRILLERS LOG

2-8-68 date well completed
GORDON McNEES firm name
RANKIN county well located

LANDOWNER: Susie Westerfield
PLAIN MISS
(mailing address)


description of formations encountered	from	to
SURFACE SOIL	0	10
SEND	10	35
Blue shale	35	216
Grey sdy sh	216	224
Grey sh Lignite	224	247
Grey sdy sh Lignite	247	348
SEND	348	370
SEND sh STRS	370	470
Grey sh	470	490
Grey sh sd STRS	490	543
ROCK	543	544
ROCK sh STRS	544	550
BROWN sh	550	570
BROWN sh ROCK STRS	570	607
ROCK	607	610
BROWN sh	610	620
SEND	620	706
BROWN sh	706	763

WELL LOCATION:
sec. 35 T 5 N R. 1 E
3 miles SE of JACKSON
(distance) (direction) (nearest town)

WELL PURPOSE: Home
(home, irrigation, municipal, industrial)

WELL COMPLETION DATA:
(1) diameter (inches) 4" X 2"
(2) total depth (feet) 763
(3) static water level (feet) 132 below top of ground.
(4) casing steel 662
(material) (depth)
4 X 2 if telescope see back.
(size)
(5) screen 30 662
(length) (depth to top)
2" stainless steel
(size) (material)
(6) pump 1 1/2 18
(HP) (yield gpm)
Elec
(type power)
(7) electric log yes
(yes or no)
M.G.S.
(organization running log)
(8) how well bottom plugged mud

CODED

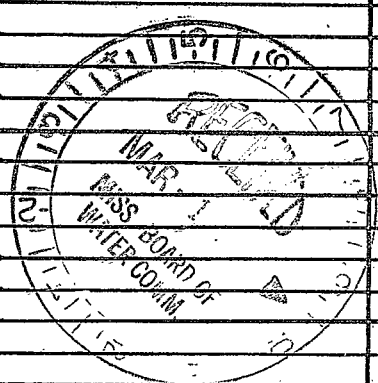

DRILLERS REMARKS:
Water
NO color

If well telescopes please sketch and show depths.

GROUND LEVEL

4" PIPE

401'

4" x 2" SWAGE

$\frac{1}{402}$

2" PIPE


$\frac{260}{662}$

30'-2" 10 slot
SCREEN

$\frac{30}{692}$

2" BLANK
PIPE WITH
BACK WASH
VALVE

$\frac{13}{705}$

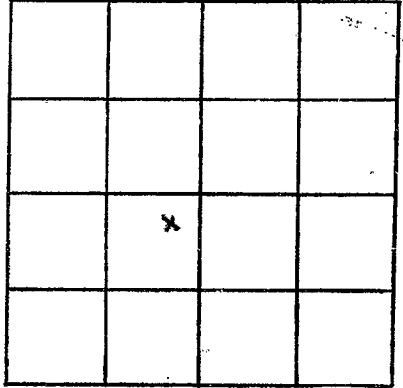

SECTION 35

Please indicate well location X.

ADDITIONAL INFORMATION

If more than one screen, show locations of each on sketch.