

ELDG #192

CODED

Rankin
 K916
 6-68
 Miss Geo Sur.
 6-15-68

MISSISSIPPI
 BOARD OF WATER COMMISSIONERS
 416 North State Street
 Jackson, Mississippi 39201

M65
 K23

WATER WELL DRILLERS LOG

date well completed 6-15-68 firm name Gordon McNeas county well located RANKIN

LANDOWNER Curtis Davis
Brandon Miss
 (mailing address)

WELL LOCATION:
 sec. 1 T 5 N R 2 E
3 miles West of Brandon
 (distance) (direction) (nearest town)

WELL PURPOSE: Home
 (home, irrigation, municipal, industrial)

WELL COMPLETION DATA: 11

(1) diameter (inches) 2

(2) total depth (feet) 762

(3) static water level (feet) 200 ^{below} / 717 ^{above} top of ground.

(4) casing 2 (material) 717 (depth)

35 If telescope see back. (size)

(5) screen 15 (length) 717 (depth to top)
2" (size) Johnson S.S. Steel (material)

(6) pump 5 (HP) Air Comp (yield gpm)
Elec (type power)

(7) electric log Yes (yes or no)
M.G.S. (organization running log)

(8) how well bottom plugged mod

description of formations encountered	from	to
SURFACE SOIL	0	10
CLAY	10	20
CLAY SD STRS	20	40
Grey shale	40	508
SANDY SH - shells	508	548
Grey sh	548	580
SAND SH STRS	580	588
Grey sh SD STRS	588	625
SAND SH STRS	625	715
SAND	715	735
SH SD STRS	735	762

35 LFS 2" 717

15' JOHNSON S.S. SCREEN 15'

1-2" Teel pipe 732

2 BECK WASH VALVE 12'

744


JUN 26 1968
 MISS. BOARD OF
 WATER COMM.

DRILLERS REMARKS:

No Color

If well telescopes please sketch and show depths.

GROUND LEVEL

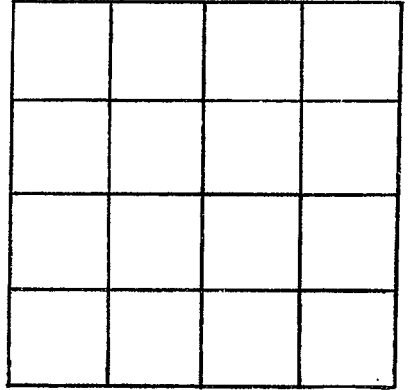

SECTION _____

Please indicate well location X.

ADDITIONAL INFORMATION

If more than one screen, show locations of each on sketch.