

Rankin
K97
10-24-68

MISSISSIPPI
BOARD OF WATER COMMISSIONERS
416 North State Street
Jackson, Mississippi 39201

CODED
MGS
K24

WATER WELL DRILLERS LOG

10/24 1968 Forest Drilling Rankin
date well completed firm name county well located

LANDOWNER:
Hedington Water Assn
Rankin County
(mailing address)

WELL LOCATION:
sec. 23 T 5 N R 2 E
miles E of Jackson
(distance) (direction) (nearest town)

WELL PURPOSE: Community
(home, irrigation, municipal, industrial)

WELL COMPLETION DATA:
(1) diameter (inches) 6"
(2) total depth (feet) 1300'
(3) static water level (feet) 245' below top of ground
(4) casing Steel 1225'
(material) (depth)
(size) if telescope see back.
(5) screen 50' 1250'
(length) (depth to top)
4" 7' Steel
(size) (material)
(6) pump 15 sub 90
(HP) (yield gpm)
ELECT
(type power)
(7) electric log Yes
(yes or no)
Miss. Geol.
(organization running log)
(8) how well bottom plugged 2"
Backwash valve

description of formations encountered	from	to
Yellow clay	0	20
Chalky clay	20	30
Silt	30	78
Blue clay	78	370
Hard shale + Rock	370	642
5th. Silt + Shale	642	724
5th. sand + Shale	724	745
Shale	745	778
5th. sand + shale	778	809
Shale	809	840
5th. Blue clay, Rock + Shale	840	1018
Soft clay	1018	1060
Hard shale	1060	1075
Shale + 5th. sand	1075	1228
Fine sand + 5th. shale	1228	1290
Shale + silt	1290	1358

CODED

JAN - 8 1969



DRILLERS REMARKS:

MISS. Bd. of
WATER COMMISSIONERS

If well telescopes please sketch and show depths.

1225' 6" Casing
 42' 4" Pipe (LAP)
 50' 4" S/S screen

GROUND LEVEL

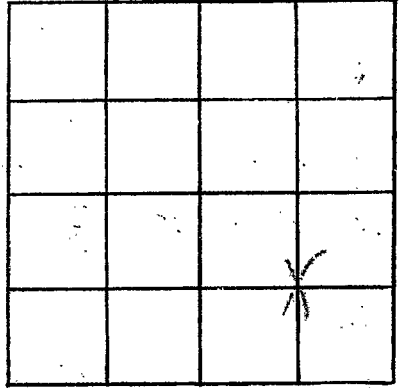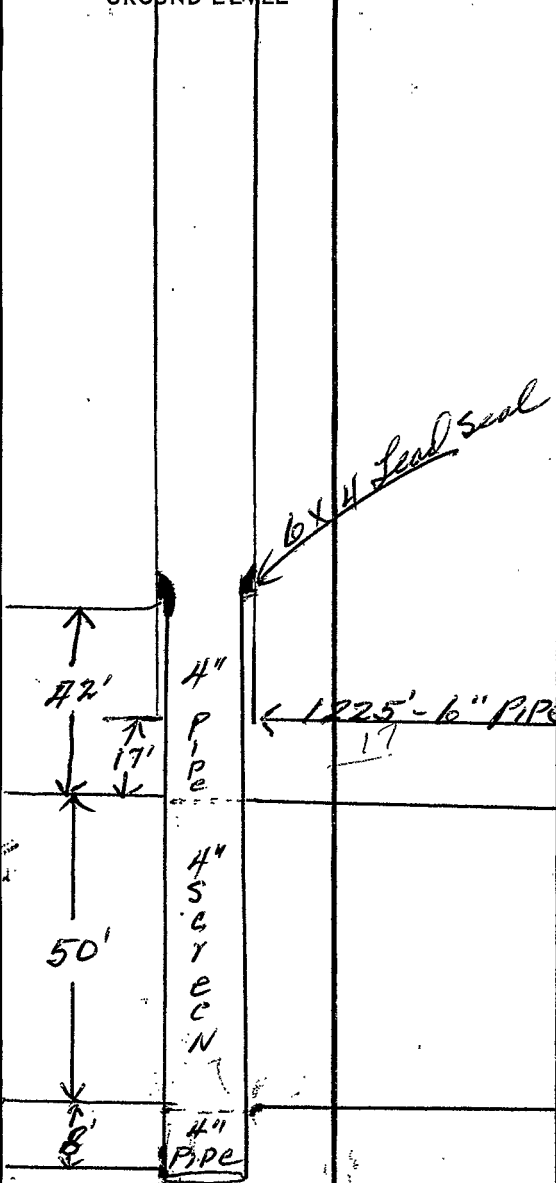

SECTION 23

Please indicate well location X.

ADDITIONAL INFORMATION

Blank lined area for additional information.

If more than one screen, show locations of each on sketch.