

CODED

Gankin
K 98
12-68
M.G.S.

MISSISSIPPI
BOARD OF WATER COMMISSIONERS
416 North State Street
Jackson, Mississippi 39201

MGS
K25

WATER WELL DRILLERS LOG

1968 Forest Drilling Gankin
date well completed firm name county well located

LANDOWNER: Olyak Johnson
Brendon, Miss.

description of formations encountered	from	to
Yellow Clay	0	22
Blue Clay	22	327
Hard Shale	327	389
Shale + Rock str	389	409
Shale + stone fine sand	409	594
Fine sand	594	615
Fine sand	615	635

(mailing address)

WELL LOCATION:

sec 22 T. 5 N R. 2 E
2 miles N of Whitfield
(distance) (direction) (nearest town)

WELL PURPOSE: Home
(home, irrigation, municipal, industrial)

WELL COMPLETION DATA:

- (1) diameter (inches) 2"
- (2) total depth (feet) 635
- (3) static water level (feet) 182 below top of ground.
- (4) casing Galv. (material), (depth)
- (size) if telescope see back.
- (5) screen 10' 625' (length) (depth to top)
2" Brass (size) (material)
- (6) pump 5 HP 15 (HP) (yield gpm)
Clark (type power)
- (7) electric log Yes (yes or no)
Miss. Geol. (organization running log)
- (8) how well bottom plugged 2" Blk. (material)

LOTT


JAN - 8 1969

MISS. BD. OF WATER COMM.

DRILLERS REMARKS:

If well telescopes please sketch and show depths.

GROUND LEVEL

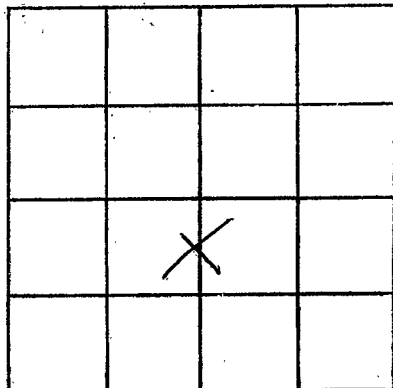

SECTION 22

Please indicate well location X.

ADDITIONAL INFORMATION

If more than one screen, show locations of each on sketch.