

MGS
CODED

MISSISSIPPI
BOARD OF WATER COMMISSIONERS
416 North State Street
Jackson, Mississippi 39201

WATER WELL DRILLERS LOG

Rankin
R 100
10/67
Elec Log

10-10 date well completed
1968 Laysan Central Co. firm name
Rankin county well located

LANDOWNER:
Metropolitan Water, Inc.
Jackson, Miss.
(mailing address)

description of formations encountered	from	to
Sandy Clay	0	5
Red Clay	5	15
White Sand (Loose)	15	40
Blue Clay	40	146
Clay strks of sand	146	186
Shale	186	230
Lime	230	232
Shale	232	273
Sandy Shale	273	360
Shale and sand strks.	360	410
Shale	410	448
Lime	448	450
Hard shale	450	491
Rock	491	497
Hard Shale	497	501
Lime	501	504
Lime, Soft strks.	504	518
Shale & Sand strks.	518	530
Fine sand, Shale breaks	530	583
Gummy shale	583	604
HARD Shale	604	607
Shale, Sandy strks.	607	615
Sand	615	643
Shale	643	645
Sand	645	653
Shale strks, Fine sand	653	695
Sand & Shale strks.	695	717
Sandy Shale	717	736
Fine sand & Shale	736	807
Fine sand	807	829
Sand	829	873
Shale	873	1015

WELL LOCATION: Old Brandon Road
sec. 17 T. 5 N R. 2 E
at Alhermar's Street EB
miles of (distance) (direction) (nearest town)


WELL PURPOSE: Domestic
(home, irrigation, municipal, industrial)

WELL COMPLETION DATA:

(1) diameter (inches) 16"
(2) total depth (feet) 867'
(3) static water level (feet) 150 below top of ground.
(4) casing Steel, 805' (material) (depth)
16" (size) if telescope see back.
(5) screen 50' length, 810' depth to top, 8" stainless steel (size) (material)
(6) pump 125 HP (HP) (yield gpm)
Electric (type power)
(7) electric log Yes (yes or no)
Schlumberger (organization running log)
(8) how well bottom plugged Valve

DRILLERS REMARKS:

No test run as of this date

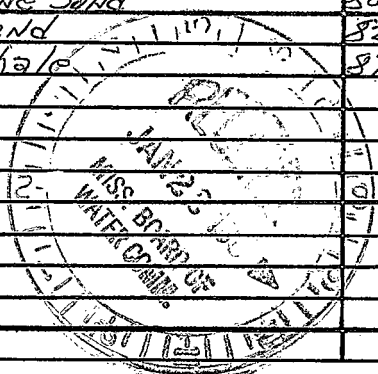

(X)

If well telescopes please sketch and show depths.

GROUND LEVEL

NW, SE, NW

	X		

SECTION 17

Please indicate well location X.

ADDITIONAL INFORMATION

If more than one screen, show locations of each on sketch.