

RANKIN
K103
8-61

WATER WELL DRILLERS LOG

CODED 300

Date: AUG, 1961, Driller: MCNEECE DRILLING CO. County RANKIN
(Name)

(1) Owner of Land: EARL CHATHAM
(Name)
JACKSON MISS
(Address)

(2) Location: NE 1/4, NW 1/4, Sec. 14 T5, R1 E
1 miles EAST of JACKSON,
(distance) (direction) (Nearest Town)

(3) Topography: FLAT
(Hilly) (Flat) (Level)

(4) Purpose of Well: INDUSTRIAL
(Domestic Irrigation
Municipal, Industrial, Other)

Description & Color of Materials Sand, Clay, Red Clay, Shell, etc.	Thick- ness Feet	Depth Feet
SURFACE SOIL	6	0
WHITE SAND	29	35
ROCK LEDGES	10	45
GREY SHALE + SAND	21	66
BLACK SANDY SHALE	148	214
FINE SAND SHALE	19	233
FINE SAND	21	254
SHALE	148	402
SANDY SHALE	85	487
SHALE	22	509
SAND	42	551
SHAKY SAND	42	593
SHALE	21	614
SAND	105	719

Information upon completion of well:

(1) Diameter 4X2 inches.

(2) Total Depth 719 feet.

(3) Water Level 120 feet below top of ground.

(4) Cased to 320, Size 4"
320' - 719' - 2"


(5) Screen: Size 2", Length 40'

(6) Were any formations sealed against pollution?
✓ yes, 1 no.

CODED

If YES depth of formation 6' - 35'
Why UNDESIRABLE WATER

Drillers Remarks:

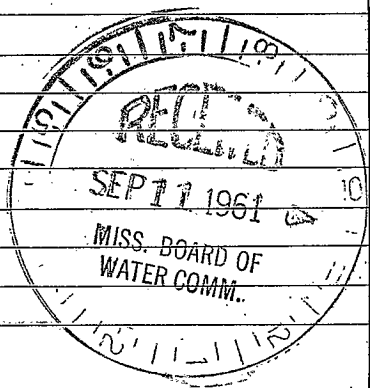

(Use Back Side)

Well No. 7

