

Rankin  
K106  
6-67

MISSISSIPPI  
BOARD OF WATER COMMISSIONERS  
416 North State Street  
Jackson, Mississippi 39201

**CODED**

WATER WELL DRILLERS LOG

6-29-67 19 Fast Drilling Rankin  
date well completed firm name county well located

LANDOWNER: J. D. Singletary

description of formations encountered from to

Pt 6  
Jackson Miss.  
(mailing address)

Clay	0	12
Hard		31
Blue Clay		40
Clay		61
Clay & Hard Shell		81
Clay		102
Clay & 1/2 in. Nuts		142
Clay		184
Clay & Silt		240
Fine Sand		301

WELL LOCATION:  
sec. 24 T 5 N R 1 E  
S E  
3/4 miles S/W of Beard  
(distance) (direction) (nearest town)


WELL PURPOSE: Home  
(home, irrigation, municipal, industrial)

WELL COMPLETION DATA:

- (1) diameter (inches) 2"
- (2) total depth (feet) 300 ft
- (3) static water level (feet) 85 below above top of ground.
- (4) casing Galv., 290  
(material) (depth)  
2" if telescope see back.  
(size)
- (5) screen 10 ft, 290  
(length) (depth to top)  
2", Galv. Bars  
(size) (material)
- (6) pump \_\_\_\_\_ (HP) \_\_\_\_\_ (yield gpm)  
(type power)
- (7) electric log No  
(yes or no)  
(organization running log)
- (8) how well bottom plugged Best  
79 lbs


**CODED**

DRILLERS REMARKS:

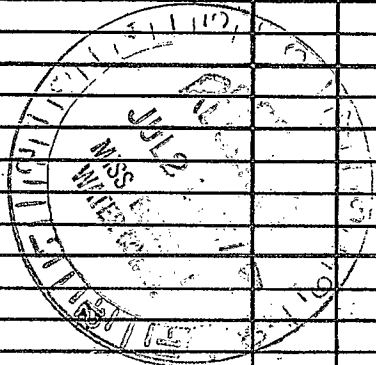

If well telescopes please sketch and show depths.

GROUND LEVEL

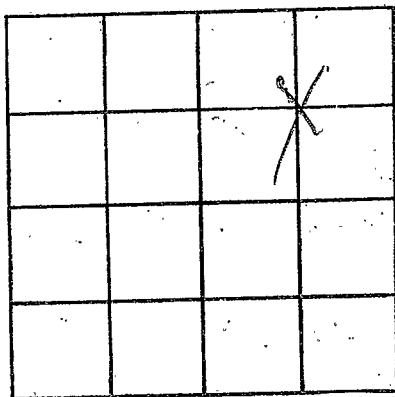

SECTION 24

Please indicate well location X.

ADDITIONAL INFORMATION

If more than one screen, show locations of each on sketch.