

RANKIN MISSISSIPPI BOARD OF WATER COMMISSIONERS

MCS

K107 Elect-LOG MGS
8-25-64 WATER WELL DRILLERS LOG

CODED

Date: 8-25, 1964, Driller: James McNeese County: Hinds

(Name)

(1) Owner of Land: Johnnie Cleveland
(Name)
JACKSON
(Address)
(2) Location: NE 1/4 SE 1/4 14 5^N E
1/2 miles south of JACKSON
(distance) (direction) (Nearest Town)
(3) Topography: ✓
(Hilly) (Flat) (Level)
(4) Purpose of Well: Trailer Park
(Domestic Irrigation
Municipal, Industrial, Other)

Description & Color of Materials Sand, Clay, Red Clay, Shell, etc.	Thick-ness Feet	Depth Feet
SURFACE SOIL	10	10
SAND	20	30
Grey shale	40	70
SAND-shale shells	10	80
Grey sdy sh	95	175
SAND	12	187
Grey sdy sh	28	215
SAND	10	225
Grey sdy sh	13	238
SAND	10	248
Grey sdy sh - sd sh Ks	11	259
SAND	24	283
SAND-sh. sh. sh Ks	35	318
Grey shale	39	357
ROCK	3	360
SHALE	45	405
ROCK	1	406
BROWN sh	24	430
Grey sdy sh	54	484
Grey sdy sh sd sh Ks	38	522
Grey sdy sh	33	555
SAND	28	583
Grey sdy sh	22	605


Information upon completion of well:

(1) Diameter 4" x 2 1/2" inches.
(2) Total Depth 605 feet.
(3) Water Level 137 feet below top of ground.
(4) Cased to 549, Size 4" x 2 1/2"
(5) Screen: Size 2 1/2", Length 40
(6) Were any formations sealed against pollution?
✓ yes, no.

If YES depth of formation _____
Why _____

Drillers Remarks: _____

CODED

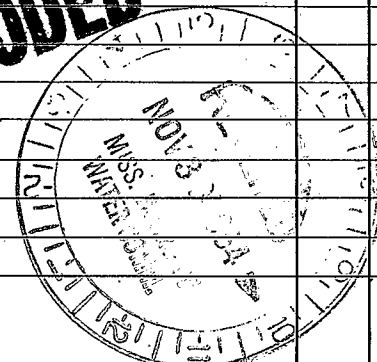

(Use Back Side)

Well No.

