

RANKIN
K108
2-25-76
EG #407

MISSISSIPPI
BOARD OF WATER COMMISSIONERS
416 North State Street
Jackson, Mississippi 39201

WATER WELL DRILLERS LOG

CODED

2-25-76 date well completed 19 Forest Drilling Service Rankin firm name county well located

LANDOWNER:
Miss Fire Training School
Whitfield
(mailing address)

description of formations encountered	from	to
Brown Clay	0	30
Blue Clay	30	204
Hard Shale	204	400
Hard shale + St. Rock	400	430
Silt + part shale	430	491
part shale	491	542
fine sand + clay	542	645
fine sand	645	671
fine sand + st. clay	671	691
Shale	691	791

WELL LOCATION:
sec 27 T 5 N R 2 E
7 miles S/E of Pearl
(distance) (direction) (nearest town)

WELL PURPOSE: IND - (state)
(home, irrigation, municipal, industrial)

- WELL COMPLETION DATA:
- (1) diameter (inches) 6"
 - (2) total depth (feet) 664'
 - (3) static water level (feet) 163' below top of ground
 - (4) casing 4" steel (material), 604' (depth)
 - (5) screen 60' (length), 604' (depth to top)
4" (size), S.S.#.008 (material)
 - (6) pump 20 (HP), 170 (yield gpm)
110V-3PB (type power)
 - (7) electric log yes (yes or no)
Miss. Geol. (organization running log)
 - (8) how well bottom plugged Back (AX2) wash valve

CODED

RECORDED
INDEXED
FEB 27 1976


DRILLERS REMARKS:

MISS. BD. OF WATER COMM

(R)

If well telescopes please sketch and show depths.

GROUND LEVEL

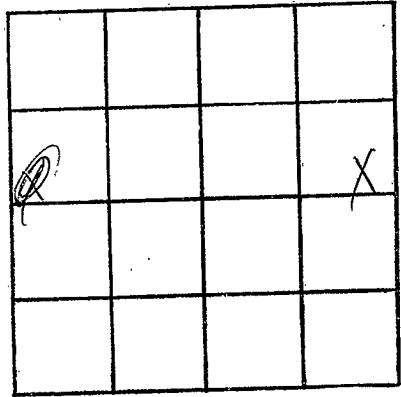

SECTION 27

Please indicate well location X.

ADDITIONAL INFORMATION

If more than one screen, show locations of each on sketch.