

RANKIN MISSISSIPPI BOARD OF WATER COMMISSIONERS

K 114

9-30-63

WATER WELL DRILLERS LOG

CODED

Date: 9/30, 1963, Driller: Forest Delgado County Walt
(Name)

(1) Owner of Land: J.A. Roberts
(Name)
Jackson & Miss
(Address)

(2) Location: 1/4, 1/4, Sec. 14 T5 R1,
1/4 miles South on old Hwy 49 of Jackson
(distance) (direction) (Nearest Town)
near scales

(3) Topography: X
(Hilly) (Flat) (Level)

(4) Purpose of Well: Home
(Domestic Irrigation)
Municipal, Industrial, Other)

Description & Color of Materials Sand, Clay, Red Clay, Shell, etc.	Thick-ness Feet	Depth Feet
Clay	0	6
Sand		25
Clay or Shale		184
Blue Clay		212
Silt & Shale		225
Fine Sand & Shale		246
Blue Clay		307
Shale		348
Shale & Shale Limestone		430
Silt & Shale		450
Silt & Shale		468
Fine Sand		475
Shale		521
Fine Sand		534
Shale		555
Silt & Shale		575
Silt Sand & Shale		610
Fine Sand		618
Shale		638
Fine Sand		682

Information upon completion of well:

(1) Diameter 2 inches.

(2) Total Depth 682 feet.

(3) Water Level 137 feet below top of ground.

(4) Cased to 672, Size 2"

(5) Screen: Size 2", Length 10ft.


(6) Were any formations sealed against pollution?
 _____ yes, X no.

If YES depth of formation _____

Why _____

Drillers Remarks: _____

CODED

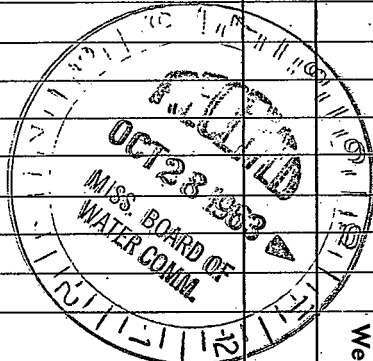

(Use Back Side)

Well No.

