

MISSISSIPPI BOARD OF WATER COMMISSIONERS

~~J.A. Rankin~~  
Rankin

3-31-62 WATER WELL DRILLERS LOG

CODED

**CODED**

Date: 3-31-1962, Driller: Layne-Central Co. County Rankin

(Name)

Jackson Municipal Airport Authority

(1) Owner of Land: Jackson, Mississippi

(Name)

Jackson, Mississippi

(Address)

(2) Location: 1/4, 1/4, Sec. 4 5 2 T 9 R E

miles of (distance) (direction) (Nearest Town)

(3) Topography: (Hilly) (Flat) (Level)

(4) Purpose of Well: Airport Authority

(Domestic Irrigation Municipal, Industrial, Other)

Information upon completion of well:

(1) Diameter 10" inches.

(2) Total Depth 623' feet.

(3) Water Level 128' feet below top of ground.

(4) Cased to 554', Size 10"

(5) Screen: Size 6", Length 60'

(6) Were any formations sealed against pollution?


X yes, no.

If YES depth of formation 554'

Why Required

Drillers Remarks:

Description & Color of Materials Sand, Clay, Red Clay, Shell, etc.	Thick-ness Feet	Depth Feet
soil	1	1
yellow clay	21	21
blue clay	303	325
hard shale	5	330
sandy shale	22	352
shale	26	378
fine sand-shale	26	404
sand	6	410
(sandy stks) shale	40	450
sandy shale	17	467
sand	13	480
fine sand-shale	20	500
sandy shale, bks saad	54	554
sand, brks shale	11	565
sand	55	620
shale	22	642
rock	1	643
shale, hard strks	83	726
rock	1	727
hard shale	9	736
rock	3	739
hard shale	12	751
rock	2	753
shale	42	795
sandy shale	13	808
shale, stks sand	27	835
shale	15	850
shale, brks sand	85	935
fine sand - shale	35	1020

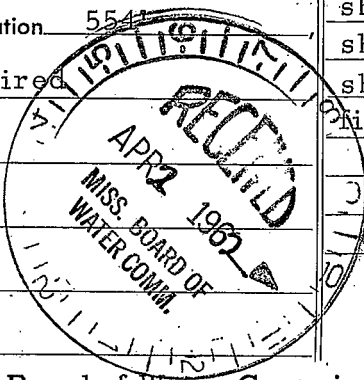

(Use Back Side)

Well No.

