

MISSISSIPPI  
BOARD OF WATER COMMISSIONERS  
416 North State Street  
Jackson, Mississippi 39201

**CODED**

**WATER WELL DRILLERS LOG**

**Rankin**  
**K 123**  
**2-12-70**

date well completed 2/12 1970 firm name Forest Drilling county well located Rankin


LANDOWNER: <u>Mr. W. McNeese</u>	description of formations encountered	from	to
241 Pemberton Drive Jackson, Miss. 39208 (mailing address)			
WELL LOCATION: sec. <u>1</u> T. <u>5</u> N. R. <u>2</u> E <u>3</u> miles <u>NW</u> of <u>Brandon</u> (distance) (direction) (nearest town)	Red clay	0	10
	Chalk clay	10	65
	Sand + sh. chalky clay	65	80
	Mucky sand	80	120
	Sand	120	140
	Blue clay	140	497
	Soft clay	497	590
	Blue shale	590	650
	Shale + sh. silt	650	710
	Silt + sh. shale	710	730
	Fine sand	730	755
	Silt sand	755	810
WELL PURPOSE: <u>None</u> (home, irrigation, municipal, industrial)			
WELL COMPLETION DATA: (1) diameter (inches) <u>2"</u>			
(2) total depth (feet) <u>758'</u>			
(3) static water level (feet) <u>260'</u> below above top of ground.			
(4) casing <u>Steel</u> , <u>743'</u> (material) (depth)			
<u>2"</u> (size) if telescope see back.			
(5) screen <u>15'</u> , <u>743'</u> (length) (depth to top)			
<u>2"</u> , <u>Stainless steel</u> (size) (material)			
(6) pump <u>Boyer</u> <u>15</u> (HP) (yield gpm)			
<u>Electric</u> (type power)			
(7) electric log <u>no</u> (yes or no)			
(organization running log)			
(8) how well bottom plugged <u>2"</u> <u>Backwash Valve</u>			
DRILLERS REMARKS:			

FEB 27 1970

MISS. BD. OF  
WATER COMMISSIONERS

If well telescopes please sketch and show depths.

GROUND LEVEL

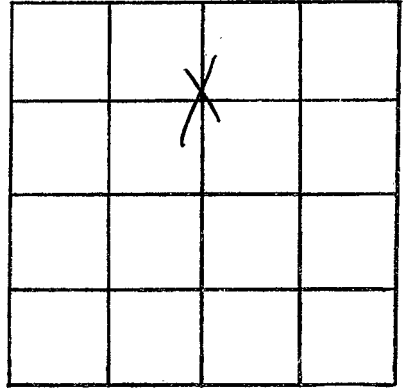

SECTION 1

Please indicate well location X.

ADDITIONAL INFORMATION

If more than one screen,  
show locations of each on sketch.