

MISSISSIPPI
 BOARD OF WATER COMMISSIONERS
 416 North State Street
 Jackson, Mississippi 39201

WATER WELL DRILLERS LOG

CODED

Rankin

K124

9-25-69

9-25-69 19
 date well completed

Des Moines
 firm name

Rankin
 county well located

LANDOWNER: Miller Oil Co.

107 West Pearl St.

Jackson Miss.
 (mailing address)

description of formations encountered

from to

Top soil

0-12

Clay

12-121

sandy shale

121-193

Clay + shale

193-552

sand

552-590

WELL LOCATION:

sec 26 T 5 N R 1 E
 2 1/2 miles south of Jackson
 (distance) (direction) (nearest town)

WELL PURPOSE:

(home, irrigation, municipal, industrial)

WELL COMPLETION DATA:

(1) diameter (inches) 4 x 2 1/2"

(2) total depth (feet) 590

(3) static water level (feet) 121 below top of ground

(4) casing Steel, 590
 (material) (depth)

(size) if telescope see back.

(5) screen 20, 590
 (length) (depth to top)

4" stainless steel
 (size) (material)

(6) pump 5 H.P.
 (HP) (yield gpm)

sub. pump
 (type power)

(7) electric log No.
 (yes or no)

(organization running log)

(8) how well bottom plugged


MAR 19 1970

MISS. BD. OF
 WATER COMM.

DRILLERS REMARKS:

If well telescopes please sketch and show depths.

GROUND LEVEL

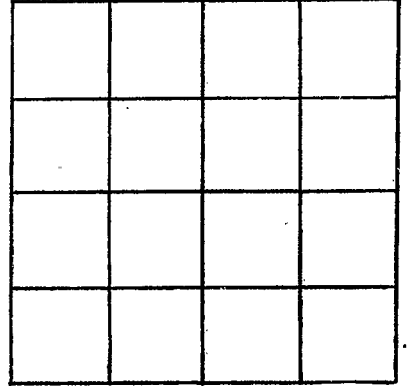

SECTION _____

Please indicate well location X.

ADDITIONAL INFORMATION

If more than one screen,
show locations of each on sketch.