

**RANKIN**  
**K125**  
**3-30-70**

MISSISSIPPI **E LOG # 247**  
 BOARD OF WATER COMMISSIONERS  
 416 North State Street  
 Jackson, Mississippi 39201

WATER WELL DRILLERS LOG

**CODED**

3/30 1970 H. E. Thompson Rankin  
 date well completed firm name county well located

LANDOWNER:  
Humble oil co.  
Jackson miss.  
 (mailing address)

description of formations encountered	from	to
<u>sandy silt</u>	<u>0</u>	<u>20</u>
<u>Blue clay</u>	<u>20</u>	<u>90</u>
<u>sand.</u>	<u>90</u>	<u>110</u>
<u>Blue clay</u>	<u>110</u>	<u>470</u>
<u>sandy clay</u>	<u>470</u>	<u>590</u>
<u>Blue clay</u>	<u>590</u>	<u>630</u>
<u>sand.</u>	<u>630</u>	<u>796</u>
<u>Brown clay</u>	<u>796</u>	<u>86</u>

WELL LOCATION:  
 sec. 14 T. 5 N. R. 2 E. W  
2 miles E of Dawl.  
 (distance) (direction) (nearest town)

WELL PURPOSE: Service to  
 (home, irrigation, municipal, industrial)

- WELL COMPLETION DATA:
- diameter (inches) 4 X 2
  - total depth (feet) 816'
  - static water level (feet) 215' below top of ground.
  - casing: Sales 760'  
 (material) (depth)  
4 X 2 if telescope see back.  
 (size)
  - screen 10' 760'  
 (length) (depth to top)  
2" S.S.  
 (size) (material)
  - pump 2 12  
 (HP) (yield gpm)  
Sub.  
 (type power)
  - electric log yes  
 (yes or no)  
M. H. S.  
 (organization running log)
  - how well bottom plugged B/W/M

**CODED**


FEB 24 1971

MISS. BD. OF  
 WATER COMM.

DRILLERS REMARKS:

If well telescopes please sketch and show depths.

GROUND LEVEL

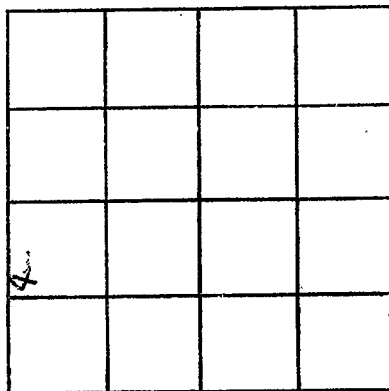

SECTION 14

Please indicate well location X.

ADDITIONAL INFORMATION

If more than one screen,  
show locations of each on sketch.