

Rankin
K 126
4-6-70
3 AC

MISSISSIPPI
BOARD OF WATER COMMISSIONERS
416 North State Street
Jackson, Mississippi 39201

CODED

WATER WELL DRILLERS LOG

April 16 1970 W. J. Bullard Rankin
Date well completed firm name county well located

LANDOWNER:

John Garner
Brandon Miss
RT (mailing address)

description of formations encountered

from

to

Red. C. 17.4	10	10
SAND C. 12.4	10	20
SAND	20	30

WELL LOCATION:

042

sec 24 T 5 S R 1 E
1/2 miles S of Pearl
(distance) (direction) (nearest town)

WELL PURPOSE:

Home
(home, irrigation, municipal, industrial)

WELL COMPLETION DATA:

- (1) diameter (inches) 2"
- (2) total depth (feet) 30'
- (3) static water level (feet) _____ below above top of ground.
- (4) casing galv. 25' (material) (depth)
2" (size) If telescope see back.
- (5) screen 5' 25' (length) (depth to top)
2" (size) SS (material)
- (6) pump 3/1 2 (HP) (yield gpm)
Electric (type power)
- (7) electric log No (yes or no)

(organization running log)

- (8) how well bottom plugged 2" B.W.D.

DRILLERS REMARKS:


CODED

APR 5 1970

MISS. DE. OF WATER COMM.

If well telescopes please sketch and show depths.

GROUND LEVEL

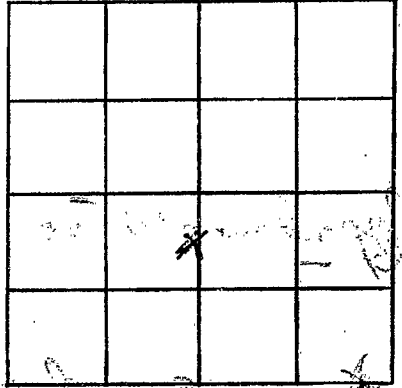

SECTION 214

Please indicate well location X.

ADDITIONAL INFORMATION

If more than one screen, show locations of each on sketch.