

E LOG #271

RANKIN
K 127
7-9-70

MISSISSIPPI
BOARD OF WATER COMMISSIONERS
416 North State Street
Jackson, Mississippi 39201

CODED

WATER WELL DRILLERS LOG

MISS. BD. OF
WATER COMM.

7/9/70 date well completed
Jack Quinn Water Well Rankin firm name
Rankin county well located

LANDOWNER: Ruben Brown
RT 4 Box 124 N,
Jackson, Miss.
(mailing address)

description of formations encountered	from	to
0-21-6 yellow clay	0	21-6
yellow sand	21-6	42-11
Blue clay	42-11	64-3
"	64-3	86-1
"	86-1	107-6
"	107-6	128-5
"	128-5	149-5
"	149-5	169-7
"	169-7	189-10
"	189-10	210-5
"	210-5	231-5
"	231-5	252-3
"	252-3	272-3
"	272-3	293-4
"	293-4	313-3
"	313-3	336-4
"	336-4	359-7
"	359-7	380-9
"	380-9	401-9
"	401-9	422-3
"	422-3	445-6
"	445-6	467-4
Blue Sand Shell	467-4	486-3
"	486-3	503-2
"	503-2	524-9
"	524-9	545-8
"	545-8	567-0
Brown mud	567-0	589-0
"	589-0	609-3
"	609-3	631-3
Sandy shell	631-3	650-11
Good sand	650-11	672-8
"	672-8	693-11
"	693-11	714-3
"	714-3	733-9
Sandy shell	733-9	754-5
"	754-5	773-11
"	773-11	793-0
"	793-0	813-0 D.

WELL LOCATION:
sec. 22 5N 2E
miles 6 of Brandon
(distance) (direction) (nearest town)

WELL PURPOSE: Home
(home, irrigation, municipal, industrial)

WELL COMPLETION DATA: 7/9/70

- (1) diameter (inches) 4 in
- (2) total depth (feet) 815 ft
- (3) static water level (feet) 165 below top of ground
- (4) casing Black pipe 6 45 ft. (material) (depth)
- (5) screen 25 ft. 6 45 (size) (length) (depth to top)
- (6) pump 2 HP 25 (size) (material) (HP) (yield gpm)
- (7) electric log yes (type power) (yes or no)
- (8) how well bottom plugged Back wash valve

DRILLERS REMARKS:


4-2 if telescope see back.
2 in Johnson
P. E. A.
Miss. S. S.

CODED

If well telescopes please sketch and show depths.

GROUND LEVEL

315 ft 4" 315 ft 21" 25 ASSS

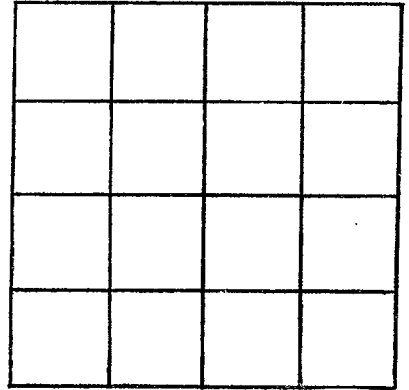

SECTION _____

Please indicate well location X.

ADDITIONAL INFORMATION

Lined area for additional information.

If more than one screen, show locations of each on sketch.