

RANKIN

K129

7-6-70

MISSISSIPPI
 BOARD OF WATER COMMISSIONERS
 416 North State Street
 Jackson, Mississippi 39201

CODED

WATER WELL DRILLERS LOG

7/6 1970 Forest Drilling Rankin
 date well completed firm name county/well located

LANDOWNER:

description of formations encountered

from

to

Carl L. Reeves
 P.O. Box 16002
 Jackson, Miss.
 (mailing address)

Clay	0	10
Clay & gravel	10	20
Blue clay	20	245
Clay + sand shale	245	286
Shale + silt + fine sand	286	307
Silt sand	307	327
Silt shale	327	337
Fine sand	337	347
Silt shale + silt	347	408
Fine sand + silt clay	408	471
Shale + fine sand	471	504
Fine sand	504	512
Fine sand + silt clay	512	533
Shale	533	585
Shale + rock	585	616
Shale	616	644
Rock	644	647
Hard shale	647	660
Rock	660	662
Shale	662	696
Silt shale + silt	696	716
Shale	716	736
Silt shale	736	776
Silt shale + silt sand	776	796
Fine sand + silt clay	796	816
Silt shale	816	828
Fine sand + clay	828	856
Shale	856	862
Fine sand	862	906

WELL LOCATION:

sec. 29 T. 5 N. R. 2 E
 2 miles S of Pearl
 (distance) (direction) (nearest town)

WELL PURPOSE:

(home, irrigation, municipal, industrial)

WELL COMPLETION DATA:

- (1) diameter (inches) 2"
- (2) total depth (feet) 906'
- (3) static water level (feet) 195' below above top of ground.
- (4) casing Steel, 886'
 (material) (depth)
2" if telescope see back.
 (size)
- (5) screen 20', 886'
 (length) (depth to top)
2", tailless steel
 (size) (material)
- (6) pump 5 Air, 20
 (HP) (yield gpm)
Collect
 (type power)
- (7) electric log NO
 (yes or no)

(organization running log)

- (8) how well bottom plugged 2"
Backward Wash

DRILLERS REMARKS:


AUG 6 1970

MISS. DE. OF WATER CONSERV.

CODED

If well telescopes please sketch and show depths.

GROUND LEVEL

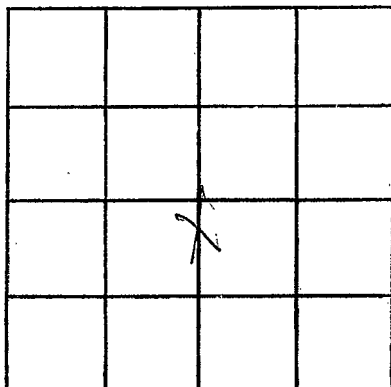

SECTION 29

Please indicate well location X.

ADDITIONAL INFORMATION

If more than one screen,
show locations of each on sketch.