

RANKIN

K132

5-22-71

MISSISSIPPI BOARD OF WATER COMMISSIONERS
416 North State Street
Jackson, Mississippi 39201

E LOG #298

CODED

WATER WELL DRILLERS LOG

5/22
date well completed

71 R. E. Thompson
firm name

Rankin
county well located

LANDOWNER:
Carl Lee Brinson

(mailing address)

description of formations encountered	from	to
<u>sand shale</u>	0	28
<u>gypsum clay</u>	40	200
<u>shale & siltstone</u>	400	500
<u>clay</u>	500	560
<u>carb. siltstone</u>	560	732

WELL LOCATION:
sec. 15 T 5 N R 2 E
3 miles E of Rankin
(distance) (direction) (nearest town)

WELL PURPOSE:
home
(home, irrigation, municipal, industrial)

- WELL COMPLETION DATA:
- (1) diameter (inches) 4 x 2 x 1 1/4
 - (2) total depth (feet) 732
 - (3) static water level (feet) 200 below top of ground.
 - (4) casing 4" (material), 580 (depth), 526 (size) If telescope see back.
 - (5) screen 10' (length), 580' (depth to top), 1 1/4" (size), S. S. C. mesh (material)
 - (6) pump 3/4 (HP), 6 (yield gpm), Sub. (type power)
 - (7) electric log yes (yes or no), M. D. S. (organization running log)
 - (8) how well bottom plugged plugged

CODED


DRILLERS REMARKS: Drilled one well, casing collapse at 250 feet to 300 ft again.

MAY 20 1971

MISS. BD. OF WATER COMM.

If well telescopes please sketch and show depths.

GROUND LEVEL

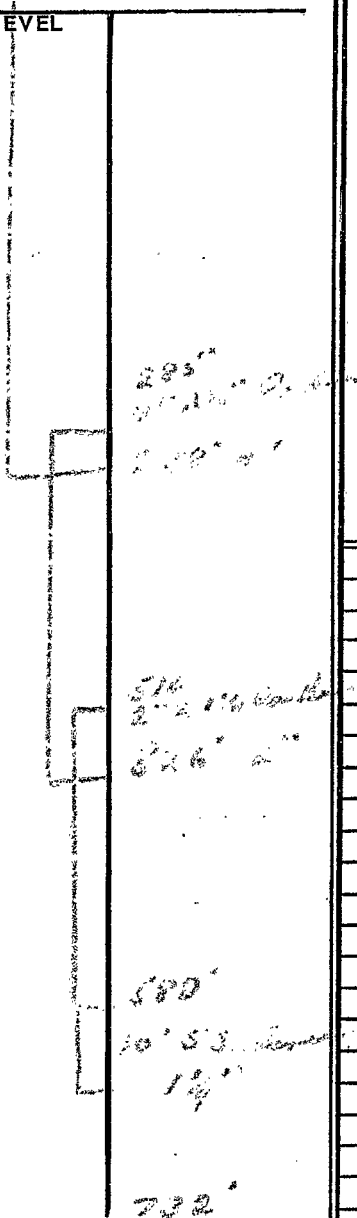

SECTION 15

Please indicate well location X.

ADDITIONAL INFORMATION

If more than one screen, show locations of each on sketch.