

RANKIN
K133

WATER WELL DRILLERS LOG

7
CODED

9-21-60

Date: SEPT. 21, 1960, Driller: MENECE DRILLING Co. County RANKIN

(1) Owner of Land: J.L. JONES
(Name)

RT, 6 Box 126 A, JACKSON MISS.
(Address)

17 52

(2) Location: 1/4, 1/4, Sec. T R

LEE PARK SUBD. BLOCK 1, LOT 2

miles of (distance) (direction) (Nearest Town)

(3) Topography: FLAT
(Hilly) (Flat) (Level)

(4) Purpose of Well: DOMESTIC
(Domestic Irrigation
Municipal, Industrial, Other)

Information upon completion of well:

(1) Diameter 4 inches.

(2) Total Depth 556 feet.

(3) Water Level 107 feet below top of ground.

(4) Cased to 300', Size 4"
300'-536'-2"

(5) Screen: Size 2", Length 20'

(6) Were any formations sealed against pollution?

yes, no.


If YES depth of formation

Why

Drillers Remarks:

Description & Color of Materials Sand, Clay, Red Clay, Shell, etc.	Thick- ness Feet	Depth Feet
WHITE CLAY	18	0
WHITE SAND	3	18
GREY SHALE	343	22
SHELL SAND & LIGNITE	23	365
SAND & SHALE	86	399
WATER SAND	82	474
		556

CODED

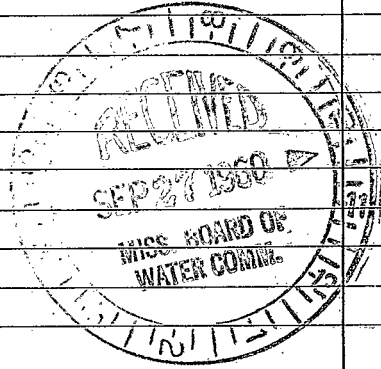

(Use Back Side)

Well No. 5

