

RANKIN
K134

WATER WELL DRILLERS LOG


CODED

12/13 to 12/14

Forrest Drilling Co.

Date: ~~1/2/63~~, 1962, Driller: James McGee County Rankin
(Name)

(1) Owner of Land: <u>Forrest T. Bell</u> (Name)	Description & Color of Materials Sand, Clay, Red Clay, Shell, etc.	Thick- ness Feet	Depth Feet
<u>Childre Rd. Jackson, Miss</u> (Address)	Clay.	11	11
(2) Location: <u>1/4, 1/4, Sec. T. R.</u> <u>13 5-1</u> _____ miles _____ of _____ (distance) (direction) (Nearest Town)	Sand.	16	27
(3) Topography: _____ (Hilly) (Flat) (Level)	Blue clay.	35	62
(4) Purpose of Well: <u>Domestic.</u> (Domestic, Irrigation, Municipal, Industrial, Other)	Fine sand.	18	80
Information upon completion of well:	Clay & mucky sand.	16	96
(1) Diameter <u>2</u> inches.	Soft clay.	56	152
(2) Total Depth <u>304</u> feet.	Clay & stks. fine sand.	45	197
(3) Water level <u>92</u> feet below top of ground.	Fine sand.	5	202
(4) Cased to <u>294'</u> , Size <u>2"</u>	Clay & mucky sand.	60	262
(5) Screen: Size <u>2"</u> , Length <u>10'</u>	Fine sand.	20	282
(6) Were any formations sealed against pollution? _____ yes, <u>X</u> no.	Sand. (Screen setting.)	22	304
If YES depth of formation _____			
Why _____			
Drillers Remarks: <u>Good well</u>			

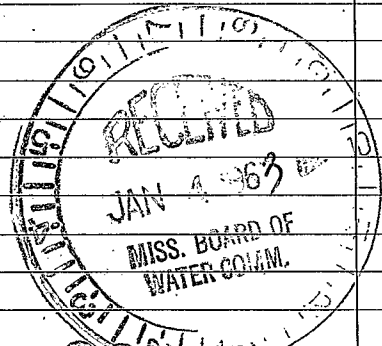

CODED

FOREST DRILLING SERV. CO.
P. O. Box 5717
PEARL BRANCH
JACKSON 8, MISS.

(Use Back Side)

Well No.

