

K136

5-24-63

WATER WELL DRILLERS LOG

CODED

Date: 5/24, 1963, Driller: M^r Kay County Rankin
 (Name)

(1) Owner of Land:	Description & Color of Materials Sand, Clay, Red Clay, Shell, etc.	Thick- ness Feet	Depth. Feet
Name: <u>T L JAMES</u>	<u>yellow clay</u>	<u>0</u>	<u>21</u>
(Address): <u>Jackson Miss</u>	<u>blue clay</u>	<u>21</u>	<u>42</u>
(2) Location: <u>city part 2 5 2</u>	<u>blue clay</u>	<u>42</u>	<u>315</u>
1/4, 1/4, Sec. T R	<u>brn clay</u>	<u>315</u>	<u>336</u>
miles of (distance) (direction) (Nearest Town)	<u>green sand clay</u>	<u>536</u>	<u>441</u>
(3) Topography: (Hilly) (Flat) (Level)	<u>sand - lignite</u>	<u>441</u>	<u>504</u>
(4) Purpose of Well: <u>Const.</u> (Domestic Irrigation, Municipal, Industrial, Other)	<u>fine sand</u>	<u>504</u>	<u>567</u>
	<u>red sand</u>	<u>567</u>	<u>619</u>
	<u>clay</u>	<u>619</u>	<u>620</u>

Information upon completion of well:

(1) Diameter 4 x 2 1/2 inches.

(2) Total Depth 619 feet.

(3) Water Level 130 feet below top of ground.


(4) Cased to 315, Size 4"

(5) Screen: Size 007, Length 40

(6) Were any formations sealed against pollution?
 _____ yes, no.

5 ft. 3 ft. H
Sub
approx 90 gal min

CODED

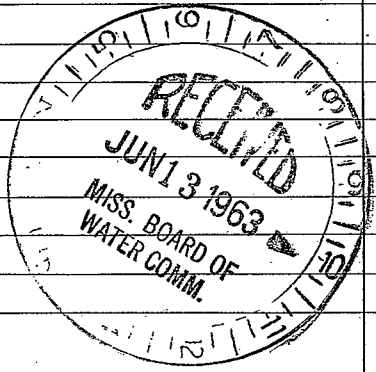

(Use Back Side)

Well No.

