

RANKIN
K 138

MISSISSIPPI BOARD OF WATER COMMISSIONERS

CODED

WATER WELL DRILLERS LOG

4-21-65

Date: 4/21/65 19___, Driller: Forest Dilling county ~~Scott~~
(Name)

(1) Owner of Land: C. L. McNamee
(Name)
Rt 4 Jackson Miss.
(Address) 1 5 2

(2) Location: 1/4 Sec. T. R.
Between ~~Highway~~ + Brandon
RD
(distance) (direction) (Nearest Town)

(3) Topography: (Hilly) (Flat) (Level)

(4) Purpose of Well: Home
(Domestic Irrigation
Municipal, Industrial, Other)

Description & Color of Materials Sand, Clay, Red Clay, Shell, etc.	Thick- ness Feet	Depth Feet
Chalky Clay		82
Clay + Silt		102
Red + Silts Clay		124
Blue Clay		205
Shale		493
lime. Shell + Shale		584
Silt Red Lignite + Shale		575
Shale + Silts. Silt		597
Shale		605
Shale + Silts Sand		744
Silt + Shale		

Information upon completion of well:

(1) Diameter 2" inches.

(2) Total Depth 744 feet.

(3) Water Level 195 feet below top of ground.

(4) Cased to 179' Size 2"

(5) Screen: Size 2" Length 18

(6) Were any formations sealed against pollution?


yes, no.

If YES depth of formation _____

Why _____

Drillers Remarks: _____

CODED

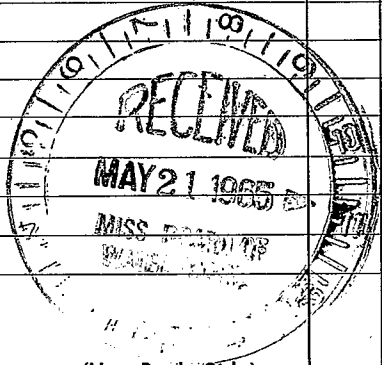

(Use Back Side)

Well No.

