

RANKIN MISSISSIPPI BOARD OF WATER COMMISSIONERS

K139

10-1-65

WATER WELL DRILLERS LOG

CODED

Date: 10/1, 1965, Driller: Forest Drilling County Ran
 (Name)


(1) Owner of Land:	Description & Color of Materials Sand, Clay, Red Clay, Shell, etc.	Thick- ness Feet	Dep- th Feet
Burns Parts & Sew (Name) P.O. Box 5885 - Jackson, Miss. (Address)	Yellow Clay Sand	9 30	9 30
(2) Location: <u>30 5 2</u> T. R. <u>3/4</u> miles <u>S/W</u> of <u>Pearl</u> (distance) (direction) (Nearest Town)	Blue Clay B. Clay, Fine, Shaly, Mud Soft Clay + Shaly Mud Clay + Shaly Sand	85 122 225 235	85 122 225 235
(3) Topography: _____ (Hilly) (Flat) (Level)	Soft Clay Soft Clay + Shaly Mud	245 282	245 282
(4) Purpose of Well: <u>W. parts plus</u> (Domestic, Irrigation, Municipal, Industrial, Other)	Soft Clay + Shaly Mud Fine Shale Fine Sand	305 317 325	305 317 325

Information upon completion of well:

- (1) Diameter 2 inches.
- (2) Total Depth 325 feet.
- (3) Water Level 85 feet below top of ground.
- (4) Cased to 315, Size 2"
- (5) Screen: Size 2", Length 10ft
- (6) Were any formations sealed against pollution?
 yes, no.

If YES depth of formation _____
 Why _____
 Drillers Remarks: _____

CODED

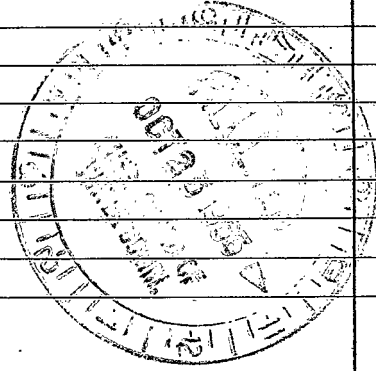

(Use Back Side)

Well No.

