

RANKIN
K 150
11-26-71

MISSISSIPPI
 BOARD OF WATER COMMISSIONERS
 416 North State Street
 Jackson, Mississippi 39201

MAR 15 1972

CODED
 WATER WELL DRILLERS LOG


Nov. 26 1971 Forest Drilling Ser. Rankin
 date well completed firm name county well located

LANDOWNER	description of formations encountered	from	to
Capital White Tusk Co -	Clay	0	8
	Sand	8	34
Hwy 80 E. Jackson, Miss (mailing address)	Clay	34	40
	Clay + Shale	40	60
WELL LOCATION:	Clay	60	81
sec. 13 T. 5 N. R. 1 E	Clay + Mucky Sand	81	< 102
2 miles E of Jackson (distance) (direction) (nearest town)	Clay + fine sand	102	122
WELL PURPOSE: 1 No - (home, irrigation, municipal, industrial)	Clay + other Mucky Sand	122	143
WELL COMPLETION DATA:	Clay	143	163
(1) diameter (inches) 2"	Clay + other fine sand	163	245
(2) total depth (feet) 687 ft	Clay	245	255
(3) static water level (feet) 122 below top of ground.	fine sand	255	273
(4) casing galv. 6 7/2' (material) (depth)	Clay	273	285
2" (size) if telescope see back.	Clay + other fine sand	285	293
(5) screen 15 ft 6 7/2' (length) (depth to top)	Clay	293	321
2" (size) Stainless Steel (material)	Clay + other rock	321	327
(6) pump 5 (HP) 70 (gpm) (yield gpm)	Clay	327	388
Electric (type power)	Clay + other rock	388	430
(7) electric log no (yes or no)	Clay + other fine sand	430	512
(organization running log)	fine sand + shale	512	532
	fine sand	532	538
	shale	538	558
	fine sand	558	573
	shale	573	626
	fine sand	626	636
	fine sand + other Clay	636	653
	fine sand	653	687
(8) how well bottom plugged 2" Back - wash valve			
DRILLERS REMARKS:			

CODED

If well telescopes please sketch and show depths.

GROUND LEVEL

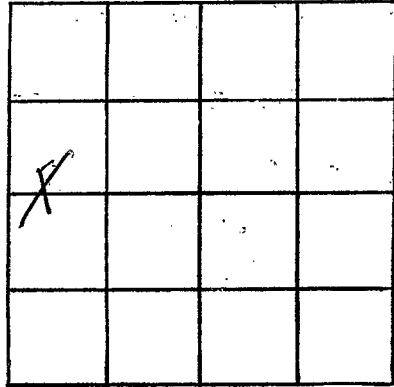

SECTION 13

Please indicate well location X.

ADDITIONAL INFORMATION

If more than one screen,
show locations of each on sketch.