

ELQ #357

RANKIN
K152
5-15-72

MISSISSIPPI
BOARD OF WATER COMMISSIONERS
416 North State Street
Jackson, Mississippi 39201

CODED

WATER WELL DRILLERS LOG

5-15-72 19 Forest Drilling Sew Rankin
date well completed firm name county well located

LANDOWNER:
Svenshine Water Assn
Brandon, Miss
(mailing address)

WELL LOCATION:
sec 13 T 3N N R 26 E
S W
3 miles West of Brandon
(distance) (direction) (nearest town)

WELL PURPOSE: Domestic
(home, irrigation, municipal, industrial)

- WELL COMPLETION DATA:
- (1) diameter (inches) 2"
 - (2) total depth (feet) 729
 - (3) static water level (feet) 85 below top of ground.
 - (4) casing Galv. 714 (material) (depth)
2" (size) if telescope see back.
 - (5) screen 15ft 714 (length) (depth to top)
2" Stainless Steel (size) (material)
 - (6) pump B4 owner 18 (HP) (yield gpm)
Elec 220v (type power)
 - (7) electric log yes (yes or no)
 - (8) how well bottom plugged Miss. Geological (organization running log)
2" Backwash valve

description of formations encountered	from	to
Clay	0	22
gray sand	22	25
Blue Clay	25	28.5
Shale + Blue Clay	28.5	30.8
Gravel	30.8	34.7
Shale	34.7	57.0
Coal + Shale	57.0	55.4
Shale + Sand	55.4	62.0
Shale	62.0	62.5
Shale + Shale	62.5	64.7
fine sand	64.7	66.4
Shaly	66.4	67.7
fine sand	67.7	71.4
Sand	71.4	72.9

CODED


JUN - 6 1972

DRILLERS REMARKS:

MISS. BOARD OF WATER COMMISSIONERS

If well telescopes please sketch and show depths.

GROUND LEVEL

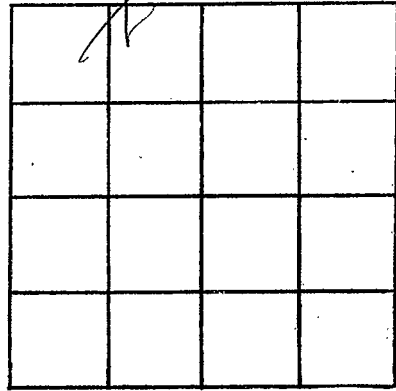

SECTION 13

Please indicate well location X.

ADDITIONAL INFORMATION

If more than one screen,
show locations of each on sketch.