

**CODED**

MISSISSIPPI  
BOARD OF WATER COMMISSIONERS  
416 North State Street  
Jackson, Mississippi 39201

RANKIN  
KISS

Log # 362

**WATER WELL DRILLERS LOG**

9-5-1972 JACKSON Rankin

date well completed

firm name

county well located

LANDOWNER: J. ALFORD  
A.C.B. BUSBY  
CROSSING RAILROAD  
(mailing address)

description of formations encountered	from	to
<u>SAND</u>	<u>0</u>	<u>15</u>
<u>CLAY</u>	<u>15</u>	<u>525</u>
<u>SAND</u>	<u>525</u>	<u>550</u>

WELL LOCATION:  
sec. 15 T. 5 N. R. 2 E  
1 miles S of PEARL  
(distance) (direction) (nearest town)

WELL PURPOSE:  
(home, irrigation, municipal, industrial)

**CODED**


- WELL COMPLETION DATA:
- (1) diameter (inches) 2"
  - (2) total depth (feet) 559
  - (3) static water level (feet) 112 below/above top of ground.
  - (4) casing JDC 530,  
(material) (depth)  
4" if telescope see back.  
(size)
  - (5) screen 2" 530  
(length) (depth to top)  
2" 55  
(size) (material)
  - (6) pump 1 10  
(HP) (yield gpm)  
REA  
(type power)
  - (7) electric log YES  
(yes or no)  
M.F.S.  
(organization running log)
  - (8) how well bottom plugged 13WU

DRILLERS REMARKS:

*APR 1972*

If well telescopes please sketch and show depths.

GROUND LEVEL

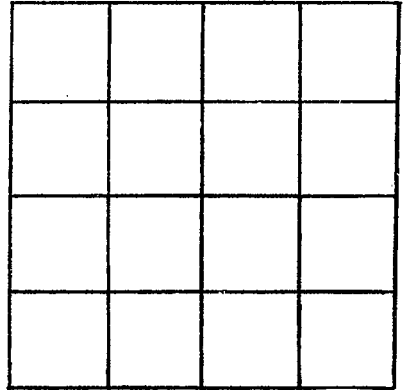

SECTION \_\_\_\_\_

Please indicate well location X.

ADDITIONAL INFORMATION

If more than one screen, show locations of each on sketch.