

RANKIN

K 159

1-17-73

MISSISSIPPI
 BOARD OF WATER COMMISSIONERS
 416 North State Street
 Jackson, Mississippi 39201
 Forest Keller Sew
 WATER WELL DRILLERS LOG

CODED

1/17 1973 date well completed
 Bell Transfer Co. Rankin firm name
 county well located

LANDOWNER: Bell Transfer Co.

description of formations encountered

from to

Storage Co.
 Rankin Ind. Park
 (mailing address)

Clay	0	10
sand	10	30
clay	30	80
clay & sts shell	80	120
clay	120	180
clay & sts fine sand	180	200
clay	200	260
clay & silt	260	280
fine sand & sts clay	280	300
fine sand	300	335

WELL LOCATION:

sec. 13 T. 5 N R. 1 E
 Childress Rd. Pearl
 (distance) (direction) (nearest town)

WELL PURPOSE: ind.
 (home, irrigation, municipal, industrial)

WELL COMPLETION DATA:

- (1) diameter (inches) 2"
- (2) total depth (feet) 335'
- (3) static water level (feet) 85' below top of ground.
- (4) casing Galv. 315'
 (material) (depth)
- (size) If telescope see back.
- (5) screen 10' 315'
 (length) (depth to top)
- 2" 51 Steel
 (size) (material)
- (6) pump 1 1/2 HP 6
 (HP) (yield gpm)
- 230V
 (type power)
- (7) electric log no
 (yes or no)
- (organization running log)

CODED

(8) how well bottom plugged? 2"
Backwash valve


DRILLERS REMARKS:

FEB 5 1973

NO. OF
LINES

If well telescopes please sketch and show depths.

GROUND LEVEL

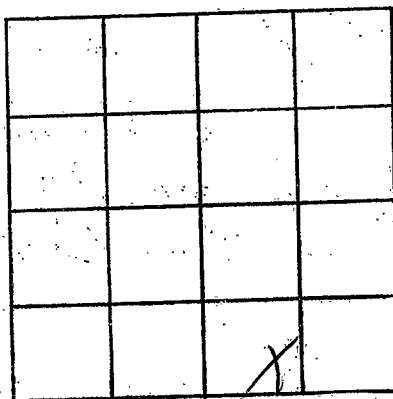

SECTION 13

Please indicate well location X.

ADDITIONAL INFORMATION

If more than one screen,
show locations of each on sketch.