

RANKIN
K160
7-20-73

MISSISSIPPI
BOARD OF WATER COMMISSIONERS
416 North State Street
Jackson, Mississippi 39201

CODED

WATER WELL DRILLERS LOG

7/30 1973 Forest Drilling Co. Rankin
date well completed firm name county well located

LANDOWNER:
Stevens Sheet Metal Co.
Rankin Industrial park
pearl (mailing address) Miss
WELL LOCATION:
sec. 13 T. 5 N. R. 1 E.
1 miles S/W of pearl
(distance) (direction) (nearest town)

description of formations encountered	from	to
<u>Brown Clay</u>	<u>0</u>	<u>16</u>
<u>Sand</u>	<u>16</u>	<u>23</u>
<u>Blue Clay</u>	<u>23</u>	<u>105</u>
<u>Blue clay + s. sta rock</u>	<u>105</u>	<u>125</u>
<u>clay</u>	<u>125</u>	<u>248</u>
<u>Clay + pit</u>	<u>248</u>	<u>268</u>
<u>clay</u>	<u>268</u>	<u>289</u>
<u>Fine sand + sta clay</u>	<u>289</u>	<u>350</u>
<u>Fine sand</u>	<u>350</u>	<u>357</u>

WELL PURPOSE: ind.
(home, irrigation, municipal, industrial)

- WELL COMPLETION DATA:
- diameter (inches) 4" x 2"
 - total depth (feet) 352
 - static water level (feet) 88' below above top of ground.
 - casing Galv. (material) 352 (depth)
 - screen 15' x 2" (length) 337 (depth to top)
2" (size) 2" #008 (material)
 - pump 1 sub. (HP) 11 (yield gpm)
electric - 230V (type power)
 - electric log no (yes or no)
no (organization running log)
 - how well bottom plugged 2" B.W. valve

CODED


SEP 20 1973

DRILLERS REMARKS:

MISS. DD. 6
MAKER COPY

If well telescopes please sketch and show depths.

GROUND LEVEL

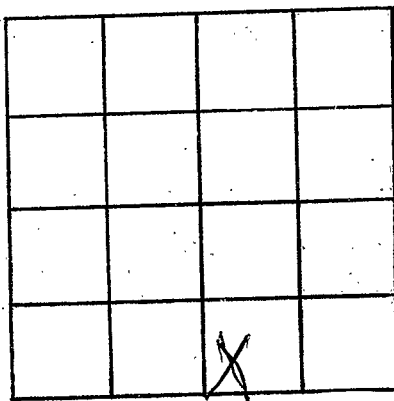

SECTION 13

Please indicate well location X.

ADDITIONAL INFORMATION

If more than one screen,
show locations of each on sketch.