

RANKIN
K 161
2-5-74

MISSISSIPPI
 BOARD OF WATER COMMISSIONERS
 416 North State Street
 Jackson, Mississippi 39201 **CODED**

WATER WELL DRILLERS LOG

2/5 1974 Forest Drilling Serv. Rankin
 date well completed firm name county well located

LANDOWNER:
 Miss pre-Engineered
 po. Box 6152, Jackson
 (mailing address)

description of formations encountered

from	to
0	12
12	19
19	266
266	286
286	327
327	348

WELL LOCATION:
 sec. 24 T 5 N R. 1 E
Rankin Ind. park
 (distance) miles (direction) of (nearest town)

WELL PURPOSE:
 (home, irrigation, municipal, industrial)

WELL COMPLETION DATA:

(1) diameter (inches) 4x2

(2) total depth (feet) 348

(3) static water level (feet) 88 below/above top of ground.

(4) casing Steel, 333 4"
 (material) (depth) (size)
4x2 if telescope see back.

(5) screen 15, 333
 (length) (depth to top)
2", SS #0080
 (size) (material)

(6) pump _____ (HP) _____ (yield gpm)
 (type power)

(7) electric log _____ (yes or no)
 (organization running log)


(8) how well bottom plugged B.N. Value

description of formations encountered	from	to
Clay	0	12
sand	12	19
Blue clay	19	266
Clay + silt	266	286
fine sand + clay	286	327
clay	327	348
CODED		
RECEIVED		
APR 1 1974		
MISS. Bd. OF WATER		

DRILLERS REMARKS:

If well telescopes please sketch and show depths.

GROUND LEVEL

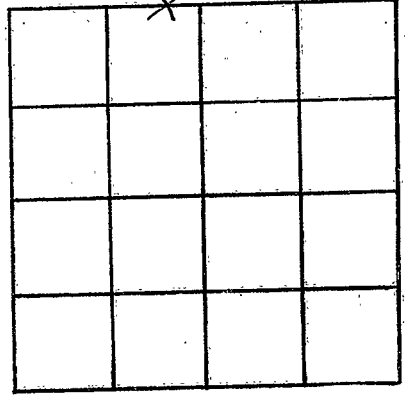

SECTION 24

Please indicate well location X.

ADDITIONAL INFORMATION

If more than one screen, show locations of each on sketch.