

RANKIN

K 162

8-8-74

Elog # 395

8-8-74

date well completed

MISSISSIPPI BOARD OF WATER COMMISSIONERS

416 North State Street

Jackson, Mississippi 39201

CODED

WATER WELL DRILLERS LOG

Rankin + increase
James M. Nees

RANKIN

firm name

county well located

LANDOWNER: J.P. Gandy

Old 49 South

JACKSON MISS (mailing address)

WELL LOCATION:

sec 14 T 5 N R 1 E
3/4 miles South of Jackson

WELL PURPOSE: HOME (home, irrigation, municipal, industrial)

WELL COMPLETION DATA:


- (1) diameter (inches) 4" x 2"
- (2) total depth (feet) 827
- (3) static water level (feet) 165 below top of ground
- (4) casing Steel 729 (material) (depth)
- (5) screen 30' 729 (length) (depth to top)
2" stainless steel (size) (material)
- (6) pump 2 (HP) 20 (yield gpm)
Elec (type power)
- (7) electric log Yes (yes or no)
M.G.S. (organization running log)

(8) how well bottom plugged Back Wash Valve

DRILLERS/REMARKS: Water Does Not Take Color

description of formations encountered	from	to
clay	0	5
SN Mb	5	30
Blue shale	30	40
Grey sh sd strk	40	250
SAND-LIGNITE	250	265
Grey sd sh	265	322
ROCK	322	323
Grey sh	323	346
ROCK STRK	346	387
Grey sh	387	527
SD STRK	527	567
SAND	567	667
Grey sh sd STRK	667	787
	787	827

18 ft COVERED		
4" x 2" SWEDGE	379	1
	780	
17 ft - 2"	349	
OLD JOHNSTON SCREEN	729	30
	759	

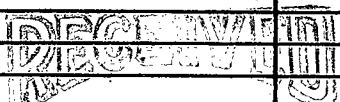

AUG 12 1974

MISS. BD. OF WATER COMMISSIONERS

If well telescopes please sketch and show depths.

GROUND LEVEL

SECTION _____

Please indicate well location X.

ADDITIONAL INFORMATION

If more than one screen,
show locations of each on sketch.