

RANKIN
K165
8/22/74
E. L. # 401

MISSISSIPPI
BOARD OF WATER COMMISSIONERS CODED
416 North State Street
Jackson, Mississippi 39201

WATER WELL DRILLERS LOG

8/22/74 19
date well completed

K. E. Thompson
firm name

Contin
county well located

LANDOWNER:

description of formations encountered

from

to

W. H. Mitchell
Paral. Miss
(mailing address)

| | | |
|------------|-----|-----|
| top soil | 0 | 5 |
| clay | 5 | 12 |
| sand | 12 | 3.5 |
| Brown clay | 35 | 220 |
| sand | 220 | 325 |

WELL LOCATION:

sec. 7 T 5 N R 2 E
8 W
1 miles N of Paral
(distance) (direction) (nearest town)

WELL PURPOSE: home
(home, irrigation, municipal, industrial)

WELL COMPLETION DATA:

- diameter (inches) 2"
- total depth (feet) 325'
- static water level (feet) 50' below top of ground.
- casing Plastic, 290' (material) (depth)
2" (size) if telescope see back.
- screen 20' (length), 290' (depth to top)
1/2", Plastic (size) (material)
- pump 3 HP (HP), 25 (yield gpm)
air well (type power)
- electric log yes (yes or no)
M. S. S. (organization running log)
- how well bottom plugged B/wave.


CODED

RECEIVED
OCT 31 1974

DRILLERS REMARKS:

If well telescopes please sketch and show depths.

GROUND LEVEL

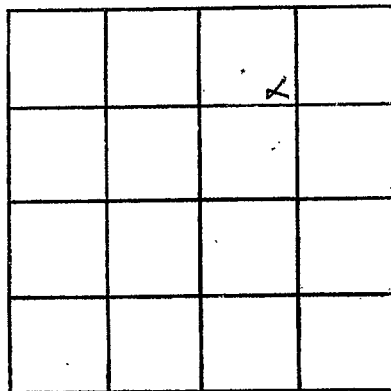

SECTION 7

Please indicate well location X.

ADDITIONAL INFORMATION

If more than one screen, show locations of each on sketch.